


FORM 51 25M 3-49 PETROL Rice

Section 24 Township 19 Range 10W

Well No. #3 Ruhl

Company Carl Lebsack

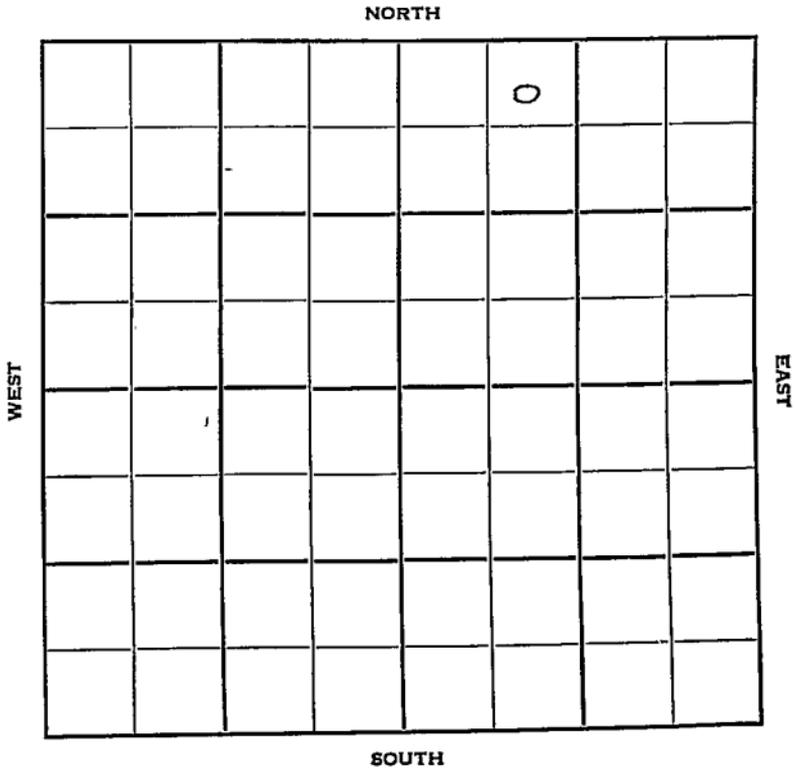

Rice

KANSAS

Sec. 24 Twp. 19 R. 10 W

Well No. # 3 Ruhl Farm

Carl Lebsack Company

Isern Drlg. Contractor

Silica Pool


330 Ft. from N. Line

_____ Ft. from S. Line

_____ Ft. from E. Line

990 Ft. from W. Line

NE NW NE

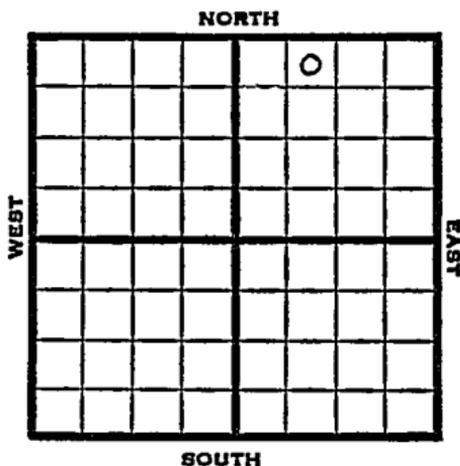

1951

Elev. 1742' REPORT

9/26

Spud 9-20-51
8" @ 141
Anhy 405'
Drlg. 1859'

11/7

Spud 9-20-51
8" @ 141
Anhy 405
Arb. 3307-10 TD
HFW
D&A

ABANDONED

County Rice State Kansas

Sec. 24 (Bik. Twp.) 19 (Sur. Rge.) 10W Map No.

Operator Carl Lebsack

Well No. 3 Farm Ruh1

Elev. _____ Location NE NW NE

330 Ft. From N Line NE

990 Ft. From W Line Quarter

1st. Report SEP 26 1951

Completion _____

Remarks _____

Isern Drlg. - Contr.

Spudding Date 9-20-51

Drlg. Data Silica Pool

8" @ 141 Anhy 405 drlg. 1859

J. E. TYRA

