


Section 24 Township 19 Range 10-W

Well No. #1 J. Finger

Company C. Lebsack

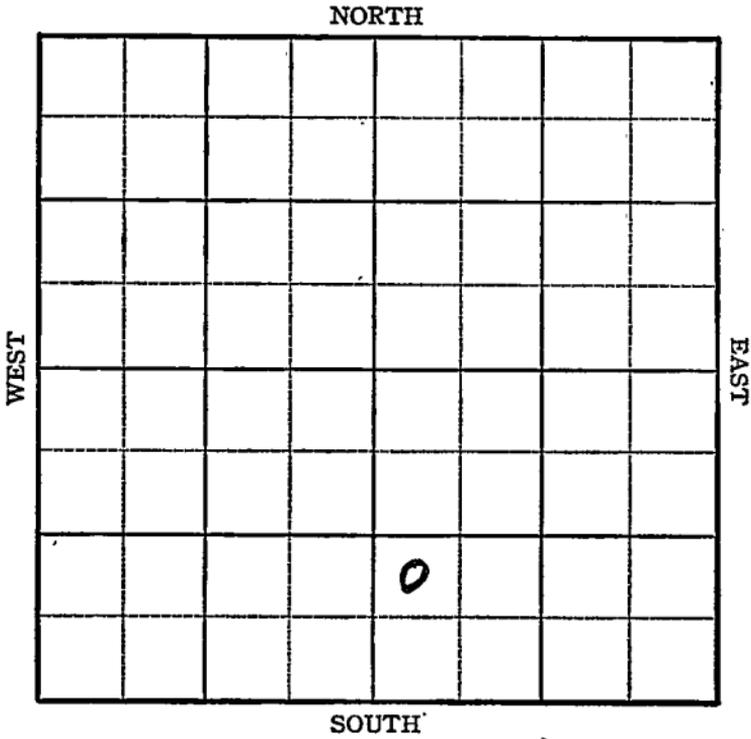

KANSAS

Rice County

Sec. 24 Twp. 19 R. 10W

Well No. #1 J. Finger Farm

C. Lebsack Company


Silica

_____ Ft. from N. Line

990 _____ Ft. from S. Line

_____ Ft. from E. Line

330 _____ Ft. from W. Line

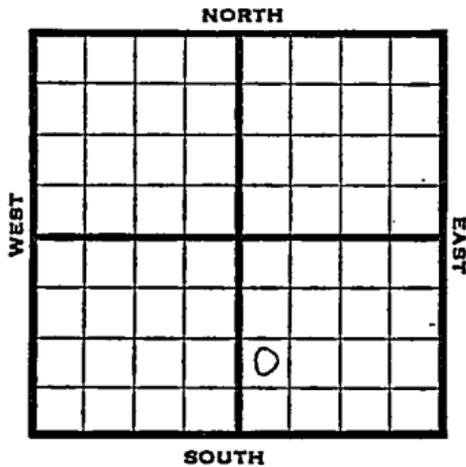


NW SW SE

1946 Elev. 1739 REPORT

2/20 SH
 2/28 8" - 208' Anhy 650'
 Drlg. 2712'
 3/6 Arb. 3307
 TD 3321'

ABANDONED

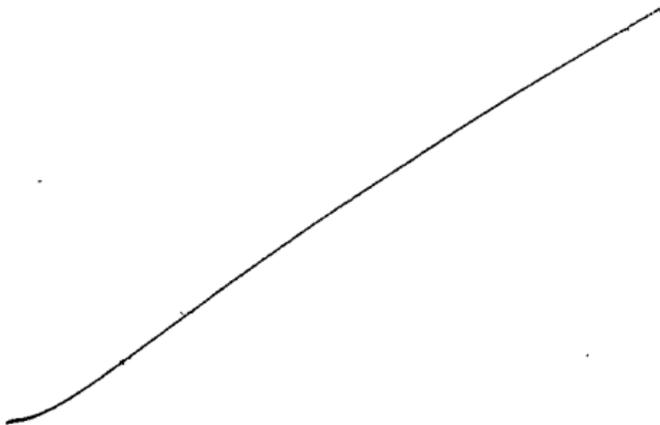

to S. ...

Handwritten initials

Handwritten signature

acir 3

France Map

Scarborough Map

Pierce Map

Geological Dept.

Pierce Plat Book

KANSAS ~~KAN~~ Pool Name Silica

Map No. 46 Sec. 24 Twp. 19 R. 10W

Well No. 1 J. Einger

C. Lebsack Company

ABANDONED Contractor

NW SW SE

E. 1789
SECTION PLAT

 Ft. from N. Line

990 Ft. from S. Line

 Ft. from E. Line

330 Ft. from W. Line

		5	

Rice County

Location

Rig up

Drilling and Remarks:

Cost 3807

RECORD

Cased in., ft.

Sand

Gas

Oil

Total Depth 2021

PRODUCTION

1st 24 hrs. Nat.

1st 24 hrs; after shot

Gas Cu. Ft.

Dry Hole

Abandoned

Date

MAR 6 1946 19

S. J. LEWIS Scout

Misc. Small Maps ~~BA~~
Cards *Scraper*
Tracing *F*
France Map ~~_____~~
Scarborough Map ~~_____~~
Pierce Map *F*
Geological Dept. _____
Pierce Plat Book _____