

DX 78-1


Rice

KANSAS

Section 25 Township 19 Range 9W

Well No. #1 Hoyt

Company Carl Lebsack

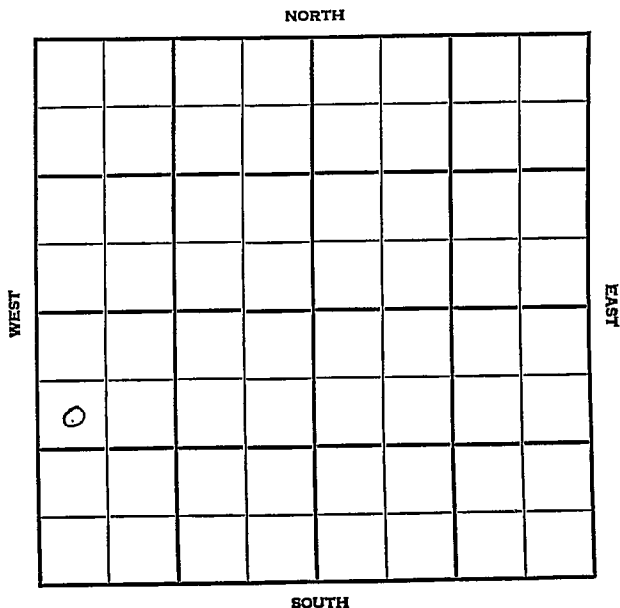

Rice

KANSAS

|      |      |    |
|------|------|----|
| SEC. | TWP. | R. |
| 24   | 19   | 9W |

WELL NO.

#1 Hoyt

FARM

COMPANY

Carl Lebsack

CONTRACTOR

Stag

Chase-Silica Pool


990' Ft. from N. Line

Ft. from S. Line

Ft. from E. Line

330' Ft. from W. Line

SW NW SW

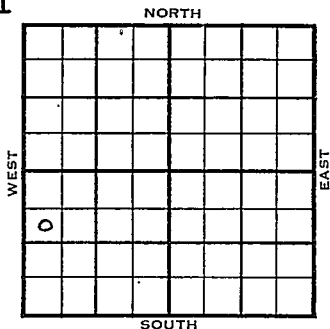

1955

ELEVATION

REPORT

6/1

8" @ 172 w/100

6/15

DST 3312-34, open 1 hr. Rec. 30' mud  
& wtr. 1100/20" D&A

| Tops     | Depth | Datum |
|----------|-------|-------|
| H.       | 2755  | 1013  |
| BL.      | 2887  | 1145  |
| L.       | 2919  | 1177  |
| C. 3233- |       | 3491  |
| S. sh    | 3209  | 1547  |
| TD.      | 3334  |       |

ABANDONED

County Rice State Kansas  
 Sec. 24 (Blk. 19 (Sur. 9W Map No.  
 (Twp.) (Rge.)  
 Operator Carl Lebsack  
 Well No. 1 Farm Hoyt  
 Elev. \_\_\_\_\_ Location SW NW SW

|  |  |  |  |  |  |  |  |  |  |
|--|--|--|--|--|--|--|--|--|--|
|  |  |  |  |  |  |  |  |  |  |
|  |  |  |  |  |  |  |  |  |  |
990 Ft. From N Line SW  
330 Ft. From W Line Quarter  
 1st. Report JUN 1 1955

Completion \_\_\_\_\_

Remarks \_\_\_\_\_

Stag Drlg. - Contr.

Spudding Date \_\_\_\_\_

Drlg. Data Chase-Silica Pool

8" @ 172 w/ 100

*[Handwritten signature/initials]*

|           |              |       |      |
|-----------|--------------|-------|------|
| County    | Rice         | Elev. | 1742 |
| Sec.      | 24           | Twp.  | 19   |
| Company   | Carl Lebsack | Rge.  | 9W   |
| Farm Name | Hoyt         | No.   | 1    |

| TOPS   | DEPTH | LOG | DATUM | Loc. in Sec. |
|--------|-------|-----|-------|--------------|
| Anh.   |       |     |       | SW NW SW     |
| Tp.    |       |     |       |              |
| H.     | 2755  |     | 1013  |              |
| Tr.    |       |     |       |              |
| Dg.    |       |     |       |              |
| Bl.    | 2887  |     | 1145  |              |
| L.     | 2919  |     | 1177  | Geol.        |
| K.C.   |       |     |       | Contr.       |
| B.K.C. |       |     |       |              |
| Ce.    |       |     |       |              |
| C.     | 3233  |     | 1497  | Stag Drlg.   |
| M.     |       |     |       | Pool         |
| M.     |       |     |       | Chase-Silica |
| K.     |       |     |       |              |
| Mz.    |       |     |       |              |
| Me.    |       |     |       |              |
| V.     |       |     |       |              |
| S. sh  | 3289  |     | 1547  |              |
| S.     |       |     |       |              |
| A.     |       |     |       |              |
| R.     |       |     |       |              |
| PE.    |       |     |       |              |
| G.     |       |     |       |              |
| T.D.   | 3334  |     |       |              |

Date Comm. 5-30-55 JUN 15 1955

8" @ 172/100 DST 3312-34 open 1 hr.

Rec. 30' mud & wtr. 1100/20"

D & A

ABANDONED