


Form 51-5M-11-31-Palace

Map No. _____ Sec. 24 Twp. 19 R. 2W
 Well No. 4 Boal Farm _____
Larion Oil & Gas Co Company

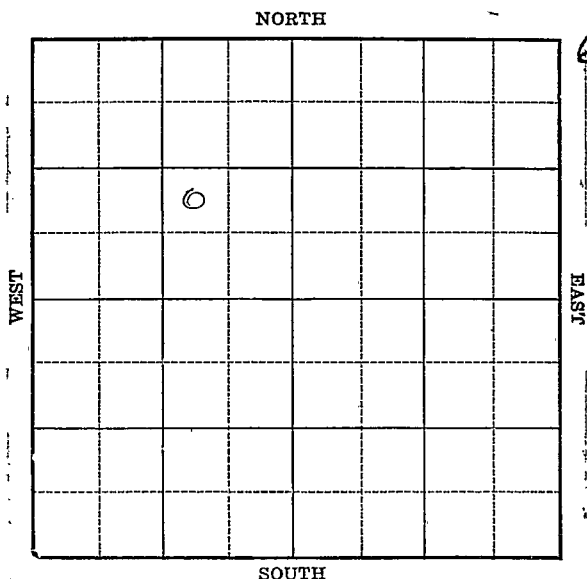

Location _____
 Drilling Remarks _____

Rig Up _____
 Drilling Remarks _____

RECORD

Cased _____ in. _____ ft.
 Sand _____
 Gas _____
 Oil _____
 Total Depth _____

PRODUCTION

1st 24 hrs. Nat. _____
 1st 24 hrs. after shot _____
 Gas _____ cu. ft.
 Dry Hole _____
 Abandoned _____

KANSAS


M. E. Pherson

Map No. _____ Sec. 24 Twp. 19 R. 2 ^WWell No. 4 Boal Farm _____Lano Oil & Gas Co Company _____

_____ Ft. from N. Line

990' Ft. from S. Line990' Ft. from E. Line

_____ Ft. from W. Line

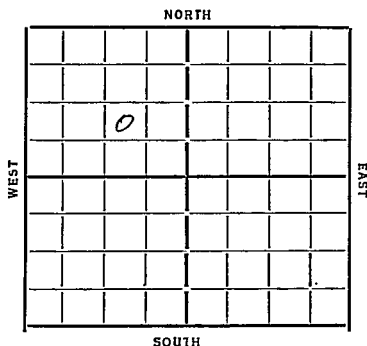1933
Date

REPORT

3/8 R.O.G.
3/12 Cement 15" - 128'
3/22 Top K to line 2320 dly 2395'
3/29 Top Chat 2933 Cement 5" Heat
7/4 J.O. 2937 Swab 63 bbls oil show
water treated with 500 gal acid
4/12 deepening to 3075 Rep Rig
4/19 Base Line 3131-5"-3405 Top Viola
3405' show oil
4/26 Testing
5/3 5" 3405 Viola 3405-3412
Swab 4 BBl per hr
Treated 1000 gal acid potential
prod 454 bbls
Completed

43 KANSAS

Map No. _____ Sec. 24 Twp. 19 R. 2

Well No. 4 Boat

Laird Oil & Gas Co. Company

Contractor

FIRST REPORTS

_____ Ft. from N. Line

990 Ft. from S. Line

990 Ft. from E. Line

_____ Ft. from W. Line

SECTION PLAT

	o		

Location _____

Rig up _____

Drilling and Remarks:

Rog

RECORD

Cased _____ in., _____ ft.

Sand _____

Gas _____

Oil _____

Total Depth _____

PRODUCTION

1st 24 hrs. Nat. _____

1st 24 hrs. after shot _____

Gas _____ Cu. Ft.

Dry Hole _____

Abandoned _____

Date

MAR 8 1933 CHAS. L. SHERWOOD

192 _____ Scout

McPherson

43 KANSAS

Map No. _____ Sec. 24 Twp. 19 R. 2

Well No. 4 Boal

Lario Oil & Gas Co. Company

Contractor

COMPLETED


_____ Ft. from N. Line

990 Ft. from S. Line

990 Ft. from E. Line

_____ Ft. from W. Line

SECTION PLAT

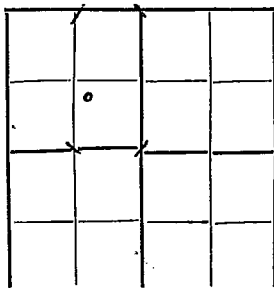

Location _____

Rig up _____

Drilling and Remarks:

Drab 4 Bls. Hard
 Tested 1000
 Sal. Acid
 Potential Prod
 454 Bls.

RECORD

Cased 5 in. 3405 ft.

Sand Viola 3405-3412

Gas _____

Oil _____

Total Depth 3412

PRODUCTION:

1st 24 hrs. Nat. _____

1st 24 hrs. after shot _____

Gas _____ Cu. Ft.

Dry Hole _____

Abandoned _____

Date

MAY 3 1933

CHAS. L. SHERWOOD

192

Scout