


McPherson

KANSAS

SECTION 24 TOWNSHIP 19 RANGE 2W

WELL NO. #2 M. Myers

COMPANY G.Hess & H.C. Bennett

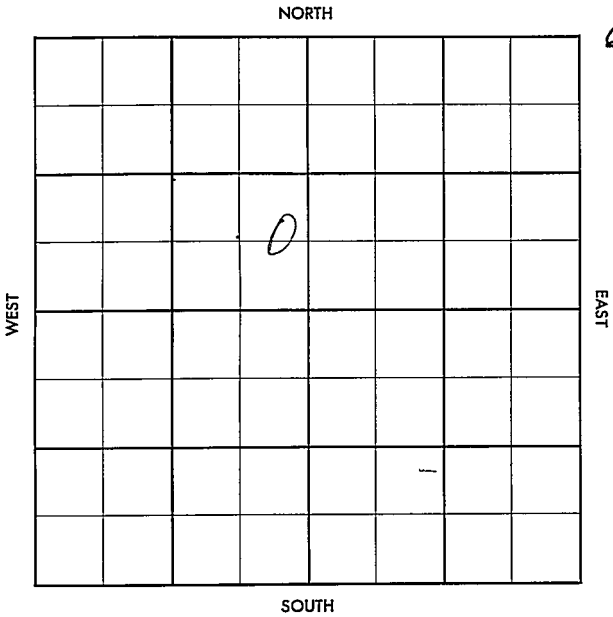

SEC.	TWP.	R.
24	19	2W

WELL NO.

#2 M. Myers

FARM

COMPANY

G. Hess & H.C. Bennett

CONTRACTOR

Mallard

Ritz-Canton


Ft. from N. Line

630

Ft. from S. Line

Ft. from E. Line

Ft. from W. Line

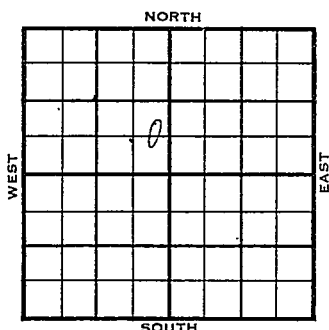C E $\frac{1}{2}$ SE NW

	ELEVATION	REPORT
1956	1552 DF	

5-16

Comm. 5-12-56
 8" @ 150 w/100
 Drlg. 1200'

5-29

5 $\frac{1}{2}$ " @ 2952
 DD 2962
 P/ 12 BO / 5 BW 24 hrs.
 KC. 2305', M. 2912'
 TD 2960'

COMPLETED

County McPherson Elev. 1552 DF
 Sec. 24 Twp. 19 Rge. 2W
 Company G. Hess & H. C. Bennett
 Farm Name M. Myers No. 2

TOPS	DEPTH	LOG	DATUM	Loc in Sec.
Anh.				C E $\frac{1}{2}$ SE NW
TP.				630' SL
H.				
Tr.				
Dg.				
Bl.				
L.				
K.C.	2305		115.2	Geol.
B.K.C.				Contr.
Ce.				Mallard
C.				
M.	2912		136.0	Pool
M.				Ritz-Canton
K.				
Mz.				
Mo.				
V.				
S.				
S.				
A.				
R.				
PE.				
G.				
T.D.	2960			

Date Comm. 5-12-56 MAY 29 1956

8" @ 150/100 drlg. 1200 MAY 23 '56

5 1/2 @ 2952 MICT CO MAY 29 '56 DD

2962 TP 11 P. 12 B0 + 5

BW 24 hrs.

County McPherson

Elev. _____

Sec. 24Twp. 19Rgs. 2WCompany G. Hess & H. C. BennettFarm Name M. MyersNo. 2

TOPS

DEPTH

LOG

DATUM

Loc. in Sec. _____

Anh. _____ G E $\frac{1}{2}$ SE NWTp. _____ 630' SL

H. _____

Tr. _____

Dg. _____

Bl. _____

L. _____

K.C. _____

B.K.C. _____

Ce. _____

C. _____

M. _____

M. _____

K. _____

Mz. _____

Mq. _____

V. _____

S. _____

S. _____

A. _____

R. _____

Pe. _____

G. _____

T.D. _____

Geol. _____

Contr. _____

Mallard

Pool

Ritz-Canton

FIRST REPORT

MAY 16 '56

Date Comm. 5-12-568" @ 150/100 drlg. 1200

ayer S S YAM