


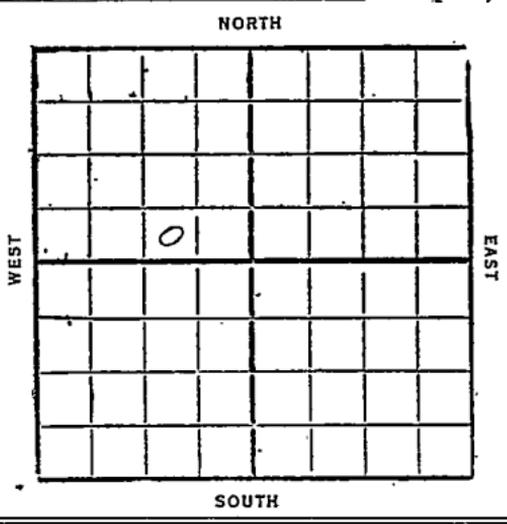

Map No. KANSAS Sec. 24 Twp. 19 R. 2<sup>w</sup>

Well No. 2-Boal Farm  
Larus & Shell Company

         Ft. from N. Line  
330 Ft. from S. Line  
990 Ft. from E. Line  
1931 Ft. from W. Line



Date	REPORT
12/30	Loc
1932	
1/7	Rod.
1/13	—
1/20	—
1/27	—
2/3	—
2/10	—
2/17	—
2/26	—
3/2	Bldg rig
3/9	Run up
3/16	Spdg
3/22	Dreg 2075'
3/30	10" - 2275'
4/5	Dreg 2380'
4/13	8" - 2536'
4/20	Dreg 2780'
	(over)

4/27- Top Chat 2938  
6"-2938

Est. 3 # gas & show oil  
from 2980-85  
UIR 6"-3100'

5/4- Cem 6"-3100' Clog out

5/11- TD 3118' Cem hole

5/18- Base line 3145  
Top Viola 3408  
Cem 5"

5/25- T.D. 3415

swab (est) 80 bbl per hour  
Rng tubing

6/11- Cased 5"-3408  
Viola 3408-15  
T.D. 3415

Potential prod  
1928 bbl  
Comp.

*McPherson*

43 KANSAS

Map No. \_\_\_\_\_ Sec. *24* Twp. *19* R. *2* <sup>W</sup>

Well No. *2* *Boal*

*Lario & Shell* Company

Contractor \_\_\_\_\_

FIRST REPORTS

\_\_\_\_\_ Ft. from N. Line

*330* Ft. from S. Line

*990* Ft. from E. Line

\_\_\_\_\_ Ft. from W. Line

SECTION PLAT

	0		

Location  \_\_\_\_\_

Rig up \_\_\_\_\_

Drilling and Remarks: \_\_\_\_\_

RECORD

Cased \_\_\_\_\_ in. \_\_\_\_\_ ft.

Sand \_\_\_\_\_

Gas \_\_\_\_\_

Oil \_\_\_\_\_

Total Depth \_\_\_\_\_

PRODUCTION

1st 24 hrs: Nat. \_\_\_\_\_

1st 24 hrs. after shot \_\_\_\_\_

Gas \_\_\_\_\_ Cu. Ft.

Dry Hole \_\_\_\_\_

Abandoned \_\_\_\_\_

Date  
DEC 3 0 1931

CHAS. L. SHERWOOD

*Answer*

Returned	<i>JP</i>
Cards	<i>JP</i>
Tracing	<i>JP</i>
France Map	<i>X</i>
Scarborough Map	<i>JP</i>
Moody Map	<i>X</i>
Scarborough Flat Book	
Moody Flat Book	

*McPherson*

**43** KANSAS W  
 Map No. \_\_\_\_\_ Sec. *24* Twp. *19* R. *2*

Well No. *2* *Boal*

*Lario* ▽ *Sheel* \_\_\_\_\_ Company

\_\_\_\_\_ Contractor

**COMPLETED**

**SECTION PLAT**

\_\_\_\_\_ Ft. from N. Line  
*330* Ft. from S. Line  
*990* Ft. from E. Line  
 \_\_\_\_\_ Ft. from W. Line

	o		

Location \_\_\_\_\_

Rig up \_\_\_\_\_

Drilling and Remarks:

*Potential Prod*  
*1928 Bls*

**RECORD**

Cased *5*" in., *3408* ft.  
 Sand *Viola 3408-3415*  
 Gas \_\_\_\_\_  
 Oil \_\_\_\_\_  
 Total Depth *3415*

**PRODUCTION**

1st 24 hrs. Nat. \_\_\_\_\_  
 1st 24 hrs. after shot \_\_\_\_\_  
 Gas \_\_\_\_\_ Cu. Ft.  
 Dry Hole \_\_\_\_\_  
 Abandoned \_\_\_\_\_

Date

**JUN 1 1932**

**CHAS. L. SHERWOOD**  
 \_\_\_\_\_ Scout



Returned	<i>[Handwritten mark]</i>
Cards	<i>[Handwritten mark]</i>
Tracing	<i>[Handwritten mark]</i>
France Map	<i>[Handwritten mark]</i>
Scarborough Map	<i>[Handwritten mark]</i>
Moody Map	<i>[Handwritten mark]</i>
Scarborough Plat Book	
Moody Plat Book	