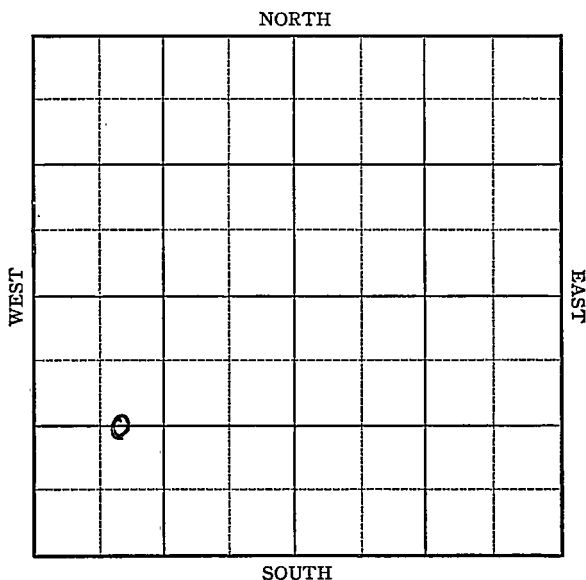



Section 24 Township 19 Range 2-WWell No. #5 GrattonCompany Nadel Gussman et al

Sec. 24 Twp. 19 R. 2-WWell.No. #5 Gratton FarmNadel Gussman et al Company

(Ritz-Canton)

 Ft. from N. Line1320 Ft. from S. Line Ft. from E. Line880 Ft. from W. Line

Elev. 1551

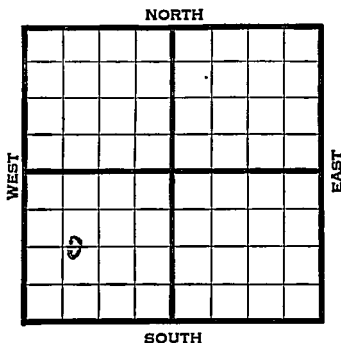

1941

REPORT

9/24

8" - 125'

Drl g. 1800'

10/2

Chat. ²⁹¹⁶~~2907~~' 5" - ²⁹²⁶~~2917~~' RUST.

10/9

" " " "

10/16

Chat. 2916' (Corrected)

5" - 2926' T.D. 2963'

1900' fluid.

10/23

" "

10/29

Chat. 2916'

5" - 2926'

T.D. 2963'

Potential 25 bbls., pump.

41.2 Gravity

COMPLETED

Map No. K-43 Sec. 24 Twp. 19 R. 2WWell No. 5 GrattonNadel Gussman et al CompanyFIRST REPORT ContractorC EL $W\frac{1}{2}$ SW Ft. from N. Line1320 Ft. from S. Line Ft. from E. Line880 Ft. from W. Line

SECTION PLAT

RITZ-CANTON POOL

Location Rig up

Drilling and Remarks:

8" - 125

Drilling 1800

RECORD

Cased in., ft.Sand Gas Oil Total Depth

PRODUCTION

1st 24 hrs. Nat. 1st 24 hrs. after shot Gas Cu. Ft.Dry Hole Abandoned

Date

SEP 24 1941

19

S J LEWIS Scout

Map No. 17-43 Sec. 24 Twp. 19 R. 2WWell No. 5 GrattonNadel Gussman et al Company**COMPLETED**

Contractor

C EL W 1/2 SW

SECTION PLAT

 Ft. from N. Line1320 Ft. from S. Line Ft. from E. Line880 Ft. from W. Line

RITZ-CANTON POOL

Location Rig up

Drilling and Remarks:

*Chas 2916**5" @ 2926**Pump 25 P.S.**4 1/2 Gr*

RECORD

Cased in., ft.Sand Gas Oil Total Depth 2963

PRODUCTION

1st 24 hrs. Nat. 1st 24 hrs. after shot Gas Cu. Ft.Dry Hole Abandoned

Date

OCT 29 1941 19 S. J. LEWIS Scout