


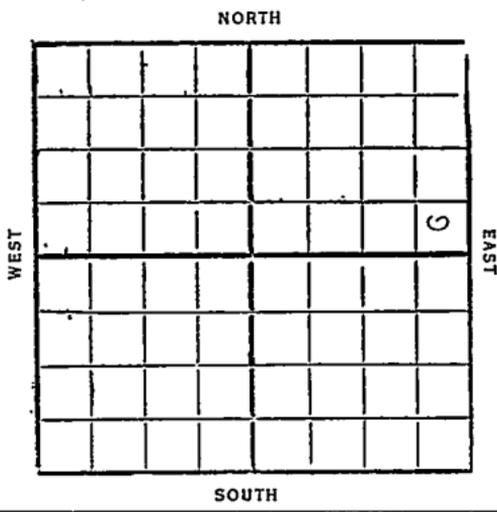

Map No. KANSAS Sec. 24 Twp. 19 R. 2<sup>w</sup>

Well No. 1 - Haley Farm  
Madison & Shell Company

         Ft. from N. Line  
326 Ft. from S. Line  
355 Ft. from E. Line  
         Ft. from W. Line



1931

Date	REPORT
1/14	Run
1/21	Recon up
1/28	Spud 750
2/4	
2/11	Drly 300'
2/18	" 560'
2/25	" 1405'
3/4	" 1885'
3/11	SD 1885'
3/18	TD. 2472' UIR 8"
3/25	
4/1	Drly 2715'
4/8	Top chat <del>2927</del> 2928 set 6"
4/15	show gas 2929-31 show oil 2950 Water at 2955
4/22	Drly 2980' UIR 6" at 3150'
4/29	
	(over)

5/6- Top Viola 3397  
T.D. 3400'

Had 2500' oil in 12 hrs

5/13- T.D. 3400' No test

5/20- T.D. 3400' Re-cem 5"

5/27- T.D. 3414 Hole full oil  
Kill test

6/3- Viola 3397-3414  
T.D. 3414

2714 bbl oil  
potential prod  
Comp.

Map No. **KANSAS** Sec. 24 Twp. 19 R. 2 W

Well No. 1 Dale

Madison & Bell Company

Contractor

**SECTION PLAT**


..... Ft. from N. Line

826 Ft. from S. Line

855 Ft. from E. Line

..... Ft. from W. Line

**FIRST REPORTS**

Location.....

Rig up.....

Drilling and Remarks:

*Rig*

**RECORD**

Cased..... in., ..... ft.

Sand.....

Gas.....

Oil.....

Total Depth.....

**PRODUCTION**

1st 24 hrs. Nat.....

1st 24 hrs. after shot.....

Gas..... Cu. Ft.

Dry Hole.....

Abandoned.....

Date

JAN 14 1931

S. J. LEWIS

Scout



Returned	
Cards	<i>2</i>
Tracting	<i>OK</i>
France Map	<i>X</i>
Scarborough Map	<i>OK</i>
Moody Map	<i>X</i>
Scarborough Post Book	
Moody Post Book	

*McPherson*

Map No. KANSAS Sec. 24 Twp. 19 R. 2 <sup>W</sup>  
 Well No. 43 1 Hale

Madison Shell Company  
 Contractor

**COMPLETED**

**SECTION PLAT**

..... Ft. from N. Line  
326 Ft. from S. Line  
355 Ft. from E. Line  
 ..... Ft. from W. Line

			0

Location.....

Rig up.....

Drilling and Remarks:

*Potential prod  
 2714 Bbls.*

**RECORD**

Cased ..... in., ..... ft.  
 Sand *Viola* 3397-3414  
 Gas.....  
 Oil.....  
 Total Depth 3414

**PRODUCTION**

1st 24 hrs. Nat.....  
 1st 24 hrs. after shot.....  
 Gas..... Cu. Ft.  
 Dry Hole.....  
 Abandoned.....

Date

**JUN 3 1931**

.....192..... Scout



Returned	
Cards	<i>[Handwritten initials]</i>
Tracing	<i>[Handwritten initials]</i>
France Map	<i>[Handwritten initials]</i>
Scarborough Map	<i>[Handwritten initials]</i>
Moody Map	<i>[Handwritten initials]</i>
Scarborough Plat Book	<i>[Handwritten initials]</i>
Moody Plat Book	