FORM 51 10M 8-47


KANSAS

McPherson

Section 24 Township 19 Range 2-W

Well No. #3 Geattan

Company Hess & Robert etal

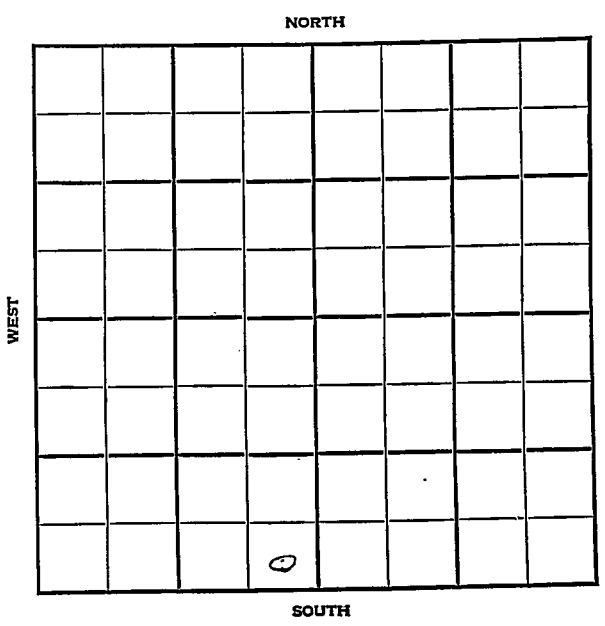

FORM 252-A'
5M 4-48 PETROL

KANSAS

McPherson ✓

Sec. 24 Twp. 19 R. 2W

Well No. #3 Geattan Farm

Hess & Robert et al Company

Ritz-Canton Pool


_____ Ft. from N. Line

330' Ft. from S. Line

330' Ft. from E. Line

_____ Ft. from W. Line

SE SW

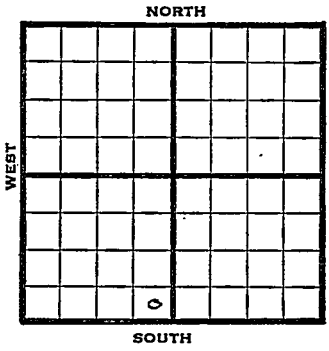

1948	Elev. 1554' REPORT
7/21	10" @ 155' Drlg. 2210'
7/28	Miss 2913-42' TD 2942'
	5" @ 2933'
8/4	"
8/11	TD 2977' 700' fluid 25% water
8/18	"
8/25	"
9/1	"
9/8	Miss 2913' 5" @ 2933' TD 2977' Pump 20 oil & 25% W Pot. Gr. 37o

COMPLETED

Form 26—200 Bks.—1-48—Palace

Kansas

Ritz-Canton Pool

Map No. _____ Sec. 24 Twp. 19 R. 2W


Well No. 3 Geattan

Hess & Robert etal. Company

FIRST REPORT Contractor

SE SW

SECTION PLAT

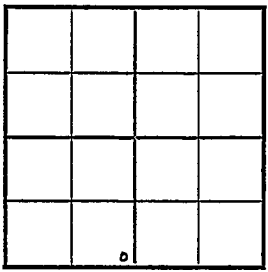

_____ Ft. from N. Line

330 Ft. from S. Line

330 Ft. from E. Line

_____ Ft. from W. Line

Mc Pherson County

Location _____

Rig up _____

Drilling and Remarks:

10" @ 155

drlg. 2210

RECORD

Cased _____ in., _____ ft.

Sand _____

Gas _____

Oil _____

Total Depth _____

PRODUCTION

1st 24 hrs. Nat. _____

1st 24 hrs. after shot _____

Gas _____ Cu. Ft.

Dry Hole _____

Abandoned _____

Date

JUL 21 1948 19 S. J. LEWIS Scout

Form 27—100 Bks.—4-48—Petrol

McPherson County Kansas State

Map No. 43 Sec. 24 Twp. 19 R. 2W

Well No. 3 Grattan

Hess & Robert etal. Company


COMPLETE

Contractor

SE SW

El. 1504

SECTION PLAT

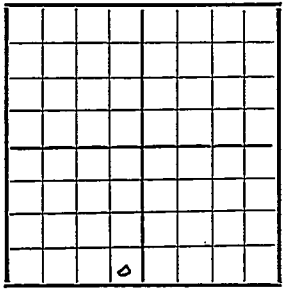

____ Ft. from N. Line

330 Ft. from S. Line

330 Ft. from E. Line

____ Ft. from W. Line

Ritz-Canton Pool

Remarks:

Miss 2913

5" @ 2933

T.D. 2977

Pump 20 oil + 25 To W Bot

87 ½ Gr

Date SEP 8 1948

Scout S. J. LEWIS