


Map No. KANSAS Sec. 24 Twp. 19 R. 2^w

Well No. 3-Gratton Farm
Lario & Shell Company

 Ft. from N. Line
3.30 Ft. from S. Line
990 Ft. from E. Line
 Ft. from W. Line
1932

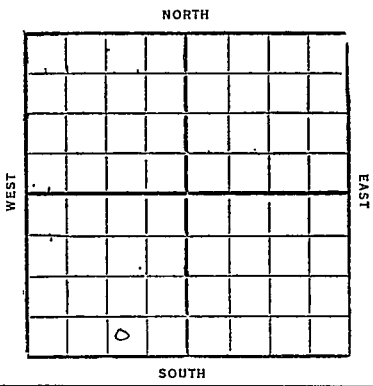

Date	REPORT
7/27	Bldg rig
8/3	Rdn rig
8/10	20"-60
	15"-545
	Dreg 925'
8/17	12"-1465
	dreg 1875
8/24	10"-2247
	dreg 2310'
8/31	" 2555'
9/17	Top Chat 2912
	" TD 2916 J
	show gas
	UIR 8" csg
9/14	TD 2916 dreg in
9/21	TD 2978
	swab (est) 200 bbl day
	some water
9/30	Chat 2912-78
	TD 2978
	Est 400 bbl oil - 6 to 10% water
	Comp 1 1/2 # gas

1934 OWDD

1/17 DIG. DEEPER

1/24 Base Level 3130

Viola 3387 - run 5"

1/31 TD 3402. 1000 gal acid WDA

2/7 - Viola 3387 TD 3407
1000 gal acid 391 Pot.

COMPLETED

McPherson

43

Map No. **KANSAS** Sec. *24* Twp. *19* R. *2* ^W

Well No. *3* *Gratten*

Lario & Shell Company

Contractor

FIRST REPORTS

SECTION PLAT

.....Ft. from N. Line

330 Ft. from S. Line

990 Ft. from E. Line

.....Ft. from W. Line

Location.....

Rig up.....

Drilling and Remarks:

Blow Rig

RECORD

Cased.....in.,ft.

Sand.....

Gas.....

Oil.....

Total Depth.....

PRODUCTION

1st 24 hrs: Nat.....

1st 24 hrs. after shot.....

Gas.....Cu. Ft.

Dry Hole.....

Abandoned.....

Date

JUL 27 1932

192. CHAS. L. SHERWOOD Scout

Wall

Returned *J*

Cards *J*

Tracing *JWS*

France Map ✓

Scarborough Map *JWS*

Moody Map ✓

Scarborough Plat Book

Moody Plat Book

McPherson

43 KANSAS

Map No. _____ Sec. *24* Twp. *19* R. *2*

Well No. *3* *Gratton*

Laris & Sheel Company

Contractor

COMPLETED

SECTION PLAT

_____ Ft. from N. Line

330 Ft. from S. Line

990 Ft. from E. Line

_____ Ft. from W. Line

Location _____

Rig up _____

Drilling and Remarks:

Cost 400 lbs
6 to 10% Water

(Signature)

RECORD

Cased *10* in., _____ ft.

Sand *Chat 2917-2978*

Gas _____

Oil _____

Total Depth *2978*

PRODUCTION

1st 24 hrs. Nat. _____

1st 24 hrs. after shot _____

Gas *1 1/2* Cu. Ft.

Dry Hole _____

Abandoned _____

Date

SEP 3 0 1932

CHAS. L. SHERWOOD

Scout

192

[Handwritten scribbles and marks]

Returned	<i>[Handwritten mark]</i>
Cards	<i>[Handwritten mark]</i>
Tracing	<i>[Handwritten mark]</i>
France Map	<i>[Handwritten mark]</i>
Scarborough Map	<i>[Handwritten mark]</i>
Moody Map	<i>[Handwritten mark]</i>
Scarborough Plat Book	
Moody Plat Book	

Map No. 43 Sec. 24 Twp. 19 R. 2W

Well No. 3-Grattan

Lario O & B. Company

Contractor

FIRST REPORTS

..... Ft. from N. Line

330 Ft. from S. Line

990 Ft. from E. Line

..... Ft. from W. Line

SECTION PLAT

O.W.D.

Location.....

Rig up.....

Drilling and Remarks:

OT 02978

Rig up

RECORD

Cased..... in., ft.

Sand.....

Gas.....

Oil.....

Total Depth.....

PRODUCTION

1st 24 hrs. Nat.....

1st 24 hrs. after-shot.....

Gas..... Cu. Ft.

Dry Hole.....

Abandoned.....

Date

1-17-34 192 O. Manscheck Scout

W. Hall

Returned	
Cards	<i>MS</i>
Tracing	<i>MS</i>
France Map	<i>+</i>
Scarborough Map	<i>MS</i>
Moody Map	<i>+</i>
Scarborough Plat Book	
Moody Plat, Book	

McPherson
 Map No. 43 Sec. 24 Twp. 19 R. 2W
 Well No. 3-Grattan
Lario or G. Company
 Contractor

COMPLETED

SECTION PLAT

	0		

.....Ft. from N. Line

330 Ft. from S. Line

990 Ft. from E. Line

.....Ft. from W. Line

Location.....

Rig up.....

Drilling and Remarks:

1000 gal and

391 rot.

RECORD

Cased.....in.,.....ft.

Sand *Viola* 3389

Gas.....

Oil.....

Total Depth 3409

PRODUCTION

1st 24 hrs. Nat.....

1st 24 hrs. after shot.....

Gas.....Cu. Ft.

Dry Hole.....

Abandoned.....

Date

2-7-34 192 O. Manschreck Scout

Returned	
Cards	<i>RS</i>
Tracing	<i>RS</i>
France Map	<i>X</i>
Scarborough Map	<i>X</i>
Moody Map	<i>X</i>
Scarborough Flat Book	
Moody Flat Book	