



Map No. **KANSAS** Sec. 24 Twp. 19 R. 2<sup>w</sup>

Well No. 2- Stratton Farm


Dario & Shell Company

330 Ft. from N. Line

\_\_\_\_\_ Ft. from S. Line

990 Ft. from E. Line

\_\_\_\_\_ Ft. from W. Line

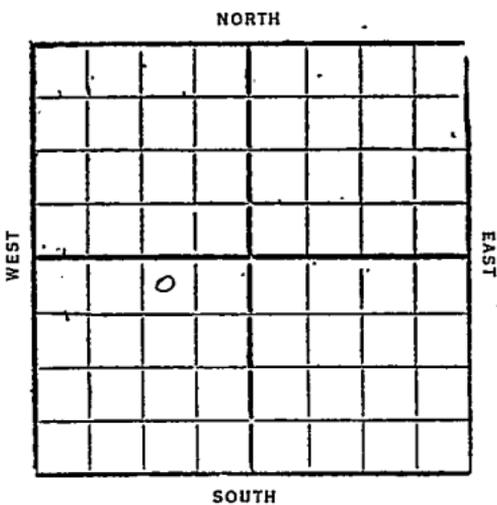

1931

Date	REPORT	O. W. D. D
<u>12/30</u>	<u>Loc</u>	
<u>1932</u>		
<u>1/7</u>	<u>—</u>	
<u>1/12</u>	<u>—</u>	
<u>1/20</u>	<u>—</u>	
<u>1/27</u>	<u>—</u>	
<u>2/3</u>	<u>—</u>	
<u>2/10</u>	<u>—</u>	
<u>2/17</u>	<u>—</u>	
<u>2/26</u>	<u>—</u>	
<u>3/2</u>	<u>—</u>	
<u>3/9</u>	<u>Collar</u>	
<u>3/16</u>	<u>—</u>	
<u>3/22</u>	<u>—</u>	
<u>3/30</u>	<u>—</u>	
<u>4/6</u>	<u>20"-90'</u> <u>Drilg 840'</u>	
<u>4/13</u>	<u>12"-1489'</u> <u>Drilg 1740'</u>	
<u>4/20</u>	<u>10"-1815'</u> <u>MFW 2185'</u> <u>Slty 8"-2263'</u>	

4/27- 8"-2494  
 drlg 2640'  
 5/4- Top Chat 2923  
 set 6"-2923  
 show gas  
 Est 5 to 6 At Gas 2925-28  
 show. oil 2988  
 drlg 2990  
 5/11- Set 6"-3090'  
 5/18- Base line 3138  
 5"-3400.  
 Viola 3400-09  
 swab 35 bbl per hr  
 5/25- T.D. 3409  
 shot 20 qt. 3401-09  
 Pumping - No test  
 6/11- Cased 5"-3400  
 Viola 3400-09  
 T.D. 3409  
 shot 20 qt 3401-09  
 Potential prod  
 1798 bbl  
 Comp.

1935

O. W. D. D

3/20 Run up to deeper  
 3/28 T.D. 3419 1500 acid  
 4/3 T.D. 3419 shot 5 qts  
 5 bbls oil.

COMPLETED

*McPherson*

43 KANSAS

Map No. \_\_\_\_\_ Sec. *24* Twp. *19* R. *2* <sup>W</sup>

Well No. *2* *Gnatten*

*Louis D. Steel* Company

Contractor

FIRST REPORTS

SECTION PLAT

*330* Ft. from N. Line

\_\_\_\_\_ Ft. from S. Line

*990* Ft. from E. Line

\_\_\_\_\_ Ft. from W. Line

	0		

Location

Rig up \_\_\_\_\_

Drilling and Remarks:

RECORD

Cased \_\_\_\_\_ in., \_\_\_\_\_ ft.

Sand \_\_\_\_\_

Gas \_\_\_\_\_

Oil \_\_\_\_\_

Total Depth \_\_\_\_\_

PRODUCTION

1st 24 hrs. Nat. \_\_\_\_\_

1st 24 hrs. after shot \_\_\_\_\_

Gas \_\_\_\_\_ Cu. Ft.

Dry Hole \_\_\_\_\_

Abandoned \_\_\_\_\_

Date  
DEC 30 1931

CHAS. L. SHERWOOD

192 Scout

*[Handwritten scribbles]*

Returned	<i>[initials]</i>
Cards	<i>[initials]</i>
Tracing	<i>[initials]</i>
France Map	<i>[initials]</i>
Scarborough Map	<i>[initials]</i>
Moody Map	<i>[initials]</i>
Scarborough Plat Book	
Moody Plat Book	

*McPherson*

*43*

KANSAS

Map No. \_\_\_\_\_ Sec. *24* Twp. *19* R. *2* <sup>W</sup>

Well No. *2* *Grattan*

*Lario & Sheel* Company

Contractor

COMPLETED

SECTION PLAT

*330* Ft. from N. Line

\_\_\_\_\_ Ft. from S. Line

*990* Ft. from E. Line

\_\_\_\_\_ Ft. from W. Line


Location \_\_\_\_\_

Rig up \_\_\_\_\_

Drilling and Remarks: \_\_\_\_\_

*Shot 20/3401-09*

*Potential Prod*  
*1798 Bbls.*

RECORD

Cased *5"* in., *3400* ft.

Sand *1/2* in. *3400-3409*

Gas \_\_\_\_\_

Oil \_\_\_\_\_

Total Depth *3409*

PRODUCTION

1st 24 hrs. Nat. \_\_\_\_\_

1st 24 hrs. after shot \_\_\_\_\_

Gas \_\_\_\_\_ Cu. Ft.


Dry Hole \_\_\_\_\_

Abandoned \_\_\_\_\_

Date

JUN 1 1932

192 CHAS. L. SHERWOOD Scout

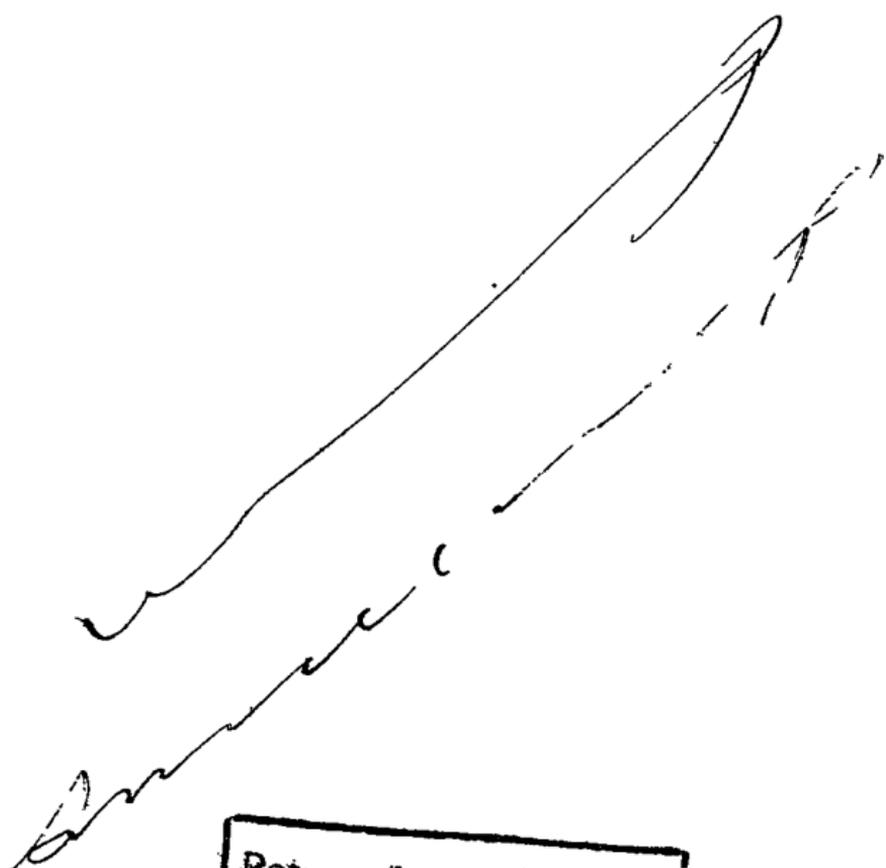

Returned	.....
Cards	.....
Tracing	.....
France Map	.....
Scarborough Map	.....
Moody Map	.....
Scarborough Plat Book	.....
Moody Plat Book	.....

Form 26 - 11/18/38  
~~777~~ Johnson

KANSA

Map No. 43 Sec. 24 Twp. 19 R. 2W

Well No. 2 - Mattan

Pariv & Shell Company

Contractor

FIRST REPORTS

330 Ft. from N. Line

..... Ft. from S. Line

990 Ft. from E. Line

..... Ft. from W. Line

QWD N

SECTION PLAT

	o		

Location.....

Rig up.....

Drilling and Remarks:

OTD 3409

Rgn

RECORD

Cased..... in.; ..... ft.

Sand.....

Gas.....

Oil.....

Total Depth.....

PRODUCTION

1st 24 hrs. Nat.....

1st 24 hrs. after shot.....

Gas..... Cu. Ft.

Dry Hole.....

Abandoned.....

Date

3-20-35 192

ORVAL MANNSCHRECK

Scout

Returned *RA*  
Cards *RA*  
Tracing *News*  
France Map *RA*  
Scarborough Map *RA*  
Moody Map *X*  
Scarborough Plat Book *RA*  
Moody Plat Book *RA*

Form 26 - 114 Bbs. 9-28  
*J. H. J. J. J. J.*

KANSAS

Map No. 43 Sec. 24 Twp. 19 R. 24

Well No. 2 - Piattan

Lario & Shell Company

Contractor

**COMPLETED**

SECTION PLAT

330 Ft. from N. Line

..... Ft. from S. Line

990 Ft. from E. Line

..... Ft. from W. Line

	0		

*QWDW*

Location.....

Rig up.....

Drilling and Remarks:

*shot 5 qts*

*5 lbs oil*

RECORD

Cased.....in., .....ft.

Sand.....

Gas.....

Oil.....

Total Depth 3419

PRODUCTION

1st 24 hrs. Nat.....

1st 24 hrs. after shot.....

Gas.....Cu. Ft.

Dry Hole.....


Abandoned.....

Date

4-3-35 192.....

**ORVAL MANNSCHECK**

Scout

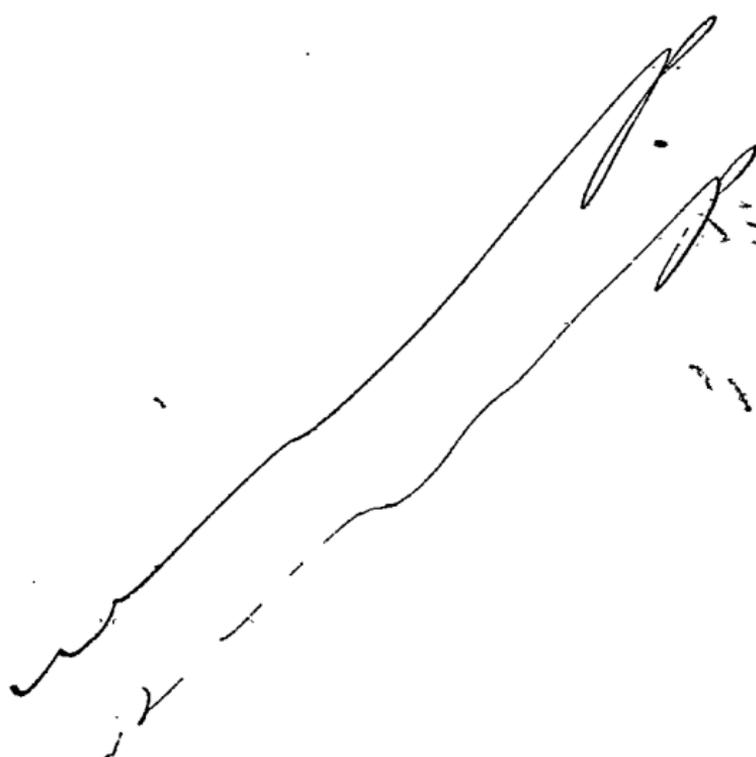

Returned	
Cards	<i>CA</i>
Tracing	<i>MUS</i>
France Map	<i>X</i>
Scarborough Map	<i>[Signature]</i>
Moody Map	<i>X</i>
Scarborough Map Book	
Moody Flat Book	