

M^cPherson


Form 51-5M-2-29-34703

Map No. **KANSAS** Sec. 24 Twp. 19 R. 2^w

Well No. 1-2aw Farm

Lario & Shell Company

NORTH

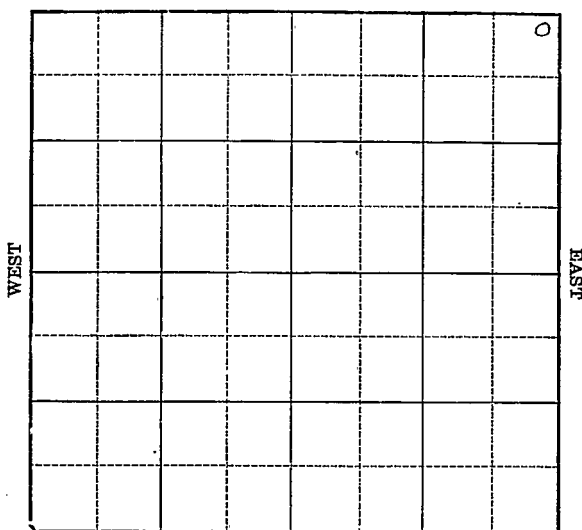

SOUTH

Location

Drilling Remarks

Rig Up

Drilling Remarks

RECORD

Cased in. ft.

Sand

Gas

Oil

Total Depth

PRODUCTION

1st 24 hrs. Nat.

1st 24 hrs. after shot

Gas cu. ft.

Dry Hole

Abandoned

Map No. **KANSAS** Sec. 24 Twp. 19 R. 2^W


Well No. 1 - Law Farm
Lario & Shell Company

125 Ft. from N. Line

_____ Ft. from S. Line

125 Ft. from E. Line

_____ Ft. from W. Line

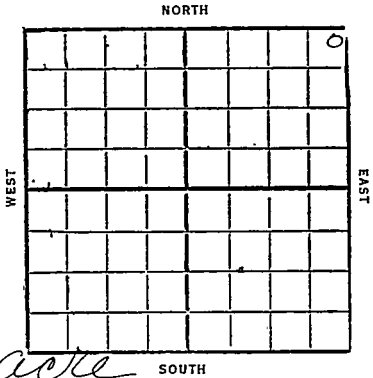

1931 school acre

Date	REPORT
12/2	Cellar
12/9	Bldg rig
12/16	Beam up
12/22	Drill
12/30	Drill 1105'
1932	
1/6	" 1870'
1/13	10" 2254'
	Drill 2280'
1/20	" 2870'
1/27	Top Chat 2953'
	Show gas 2965-70'
	8" 2972'
	Show oil 2980'
	Drill 3000'
2/3	Base line 3155'
	TD 3310' Drift out
2/9	Top Viola 3425'
	Oil 3427'
	TD 3429' No test
2/17	" TD 3429'
	Pump 25 bbl per hour cut 5%.

2/26- T.D. 3429

Pump 400 bbl oil
20% water

3/2- Cased 6"-3426

Viola 3425-30

T.D. 3430

Potential prod

844 bbls

12% water

Comp.

*McPherson**43*Map No. **KANSAS** Sec. *24* Twp. *19* R. *2*^WWell No. *1* *Law**Lario & Sheel* Company

Contractor

FIRST REPORTS

125 Ft. from N. Line

Ft. from S. Line

125 Ft. from E. Line

Ft. from W. Line

SECTION PLAT

			0

School *Acres*

Location

Rig up *Cellar*

Drilling and Remarks:

RECORD

Cased _____ in. _____ ft.

Sand _____

Gas _____

Oil _____

Total Depth _____

PRODUCTION

1st 24 hrs. Nat. _____

1st 24 hrs. after shot _____

Gas _____ Cu. Ft.

Dry Hole _____

Abandoned _____

Date

DEC 2 1931 *19* CHAS. L. SHERWOOD

Scout

[Handwritten signature]

Returned	<i>[Signature]</i>
Cards	<i>[Signature]</i>
Tracing	<i>[Signature]</i>
France Map	<i>[Signature]</i>
Scarborough Map	<i>[Signature]</i>
Moody Map	<i>[Signature]</i>
Scarborough Plat Book	
Moody Plat Book	

McPherson

43 KANSAS Map No. Sec. 24 Twp. 19 R. 2 W

Well No. 1 Law
Lario & Sheel Company

Contractor

COMPLETE

SECTION PLAT

175 Ft. from N. Line

Ft. from S. Line

175 Ft. from E. Line

Ft. from W. Line

			0

Location

Rig up

Drilling and Remarks:

Potential prod
844 bbls.

1240 water

RECORD

Cased 6 in. 3470 ft.

Sand Viola 3475-3430

Gas

Oil

Total Depth 3430

PRODUCTION

1st 24 hrs. Nat

1st 24 hrs. after shot

Gas Cu. Ft.

Dry Hole

Abandoned

Date

MAR

2 1932

CHAS. L. SHERWOOD

19

Scout

[Large handwritten signature or scribble across the top half of the page]

Returned	<i>[Signature]</i>
Cards	<i>[Signature]</i>
Tracing	<i>[Signature]</i>
Francis Map	<i>[Signature]</i>
Scarborough Map	<i>[Signature]</i>
Moody Map	<i>[Signature]</i>
Scarborough Flat Book	<i>[Signature]</i>
Moody Flat Book	<i>[Signature]</i>