


McPherson

KANSAS

Form 51—5M—11-31—Palace

Map No. _____ Sec. *24* Twp. *19* R. *2W*

Well No. *3-Saw* Farm _____
Lario + Shell Company _____

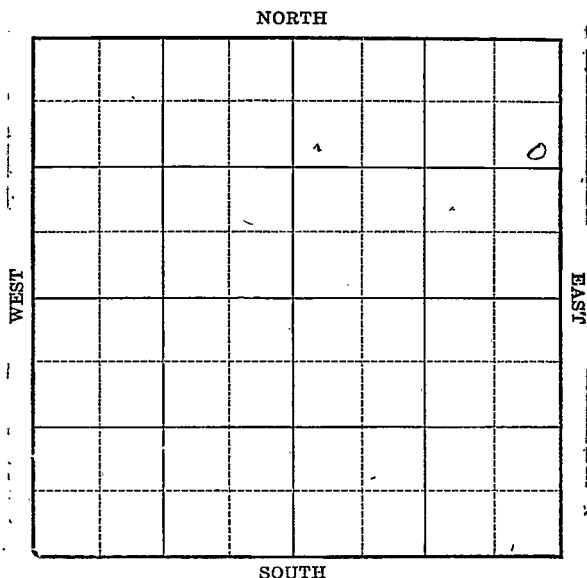

Location _____

Drilling Remarks _____

Rig Up _____

Drilling Remarks _____

RECORD

Cased _____ in. _____ ft.

Sand _____

Gas _____

Oil _____

Total Depth _____

PRODUCTION

1st 24 hrs. Nat. _____

1st 24 hrs. after shot _____

Gas _____ cu. ft.

Dry Hole _____

Abandoned _____

Map No. _____ Sec. 24 Twp. 19 R. 2W


Well No. 3 Law Farm
Lario & Shell Company

990 Ft. from N. Line

_____ Ft. from S. Line

330 Ft. from E. Line

_____ Ft. from W. Line

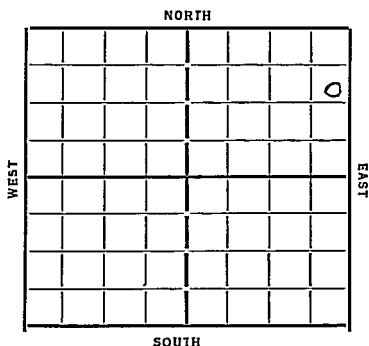

Date 1933

REPORT

7/19 Location
7/26 Pond
8/2 Rgn Deep
8/9 dly 580'
8/17 " 1310'
8/22 10" 3122' C.O.
8/30 H.T.W 2425 dly 2450'
9/6 B' at 2535 Top chat 2927 -
6" at 2912. C.O.
9/13 Top chat (corrected) 2927 - 6" at 2927
dly 3191
9/20
9/29 Top Uola 3408 - T.D. 3410
swab 15 oil + 15 water 9 hrs
will acidize 1000 gals.
10/4 Uola 3408
T.D. 3410 1000 gallon acid
150 bbls oil
75 bbls water

COMPLETED

Form 26-1M Bks. 8-26
McPherson

KANSAS

Map No. *43* Sec. *24* Twp. *19* R. *2W*

Well No. *3 - Law*

Lewis & Shell Company

Contractor

SECTION PLAT

990 Ft. from N. Line

Ft. from S. Line

330 Ft. from E. Line

Ft. from W. Line

			<i>0</i>

TEST REPORTS

Location *✓*

Rig up

Drilling and Remarks:

RECORD

Cased in, ft.

Sand

Gas

Oil

Total Depth

PRODUCTION

1st 24 hrs. Nat.

1st 24 hrs. after shot

Gas Cu. Ft.

Dry Hole

Abandoned

Date

7/19/33 192 *Coal Mannesbach* Scout

P. P.

[Handwritten signature]

Returned	
Cards	<i>[Handwritten signature]</i>
Tracing	<i>[Handwritten signature]</i>
France Map	<i>[Handwritten signature]</i>
Scarborough Map	<i>[Handwritten signature]</i>
Moody Map	<i>[Handwritten signature]</i>
Scarborough Plat Book	
Moody Plat Book	

McPherson
 Map No. 43 Sec. 24 Twp. 19 R. 2W
 Well No. 3-Law

Lario & shell Company

Contractor

SECTION PLAT

990 Ft. from N. Line

..... Ft. from S. Line

330 Ft. from E. Line

..... Ft. from W. Line

COMPLETED

			0

Location.....

Rig up.....

Drilling and Remarks:
1000 gal acid
150 oil
75 W

RECORD

Cased..... in., ft.

Sand Viola 3408

Gas.....

Oil.....

Total Depth 3410

PRODUCTION

1st 24 hrs. Nat.....

1st 24 hrs. after shot.....

Gas..... Cu. Ft.

Dry Hole.....

Abandoned.....

Date **OCT**

4 1933
 192

O. Manmick

all right

Returned	
Cards	<i>[initials]</i>
Tracing	<i>[initials]</i>
France Map	<i>[initials]</i>
Scarborough Map	<i>[initials]</i>
Moody Map	<i>[initials]</i>
Scarborough Plat Book	
Moody Plat Book	