

SECTION 24 TOWNSHIP 19S RANGE 2W

WELL NO. #1 Law

COMPANY Hess & Bennett


NORTH

C NW NE

2

WEST

EAST

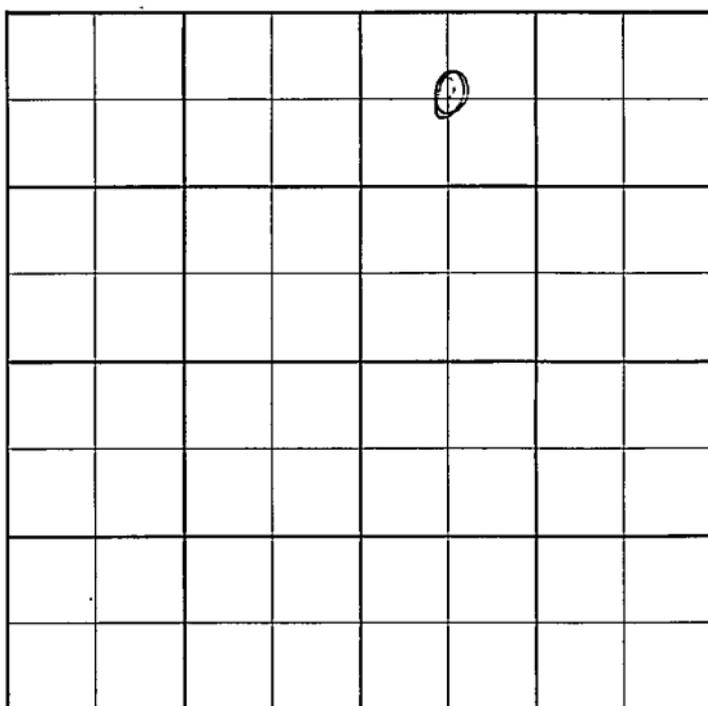

SOUTH

County McPherson Elev. _____
 Sec. 24 Twp. 19S Rgs. 2W
 Company Hess & Bennett
 Farm Name Law No. 1

Co.

TOPS	DEPTH	LOG	DATUM
Anh.			
Tr.			
H.			
Tr.			
Dg.			
Bl.			
L.			
K.C.			
B.K.C.			
Ce.			
C.			
M.			
M.			
K.			
Mz.			
Mq.			
V.			
S.			
S.			
A.			
R.			
Pe.			
G.			
T.D.			

Loc. in Sec. C NW NE

Geol. _____
 Contr. Mallard Tools

L.S.

Pool Ritz Canton

FIRST REPORT
 SEP 4 1957

No.

Date Comm. _____
 Location _____

Sec.

T.

R.



County McPherson Elev. 1559 DF
 Sec. 24 Twp. 19S Rge. 2W
 Company Hess & Bennett
 FarmName Law No. 1

TOPS	DEPTH	LOG	DATUM
Anh.			
Tp.			
H.			
Tr.			
Dg.			
Bl.			
L.			
K.C.	<u>2315</u>		
B.K.C.			
Ce.			
C.			
M. <u>chax</u>	<u>2916</u>		
M.			
K.			
Mz.			
Ma.			
V.	<u>3394</u>		
S.			
S.			
A.			
R.			
PE.			
G.			
T.D.	<u>3396</u>		

Loc. in Sec. C NW NE


Geol. _____

Contr. _____

Mallard Tools

Pool _____

Ritz Canton

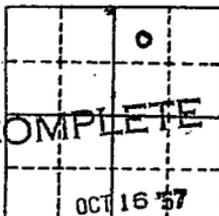

Date Comm. _____

Location SEP 11 57 9-4-57 8 209/120

2978 SEP 18 57 5 1/2 3394/125 WOC

SEP 25 57 CO 3396 10 BW ph

1/2 test OCT 2 57 Lots W PB

2970? OCT 9 57 POP OCT 15 57 30/2954-60

250A POP 15 BOPd + 50 lots wtr

15 BOPd + 50 70 W