


SECTION 24 TOWNSHIP 19 RANGE 2W

WELL NO. #2 Lovett

COMPANY Frank Jones

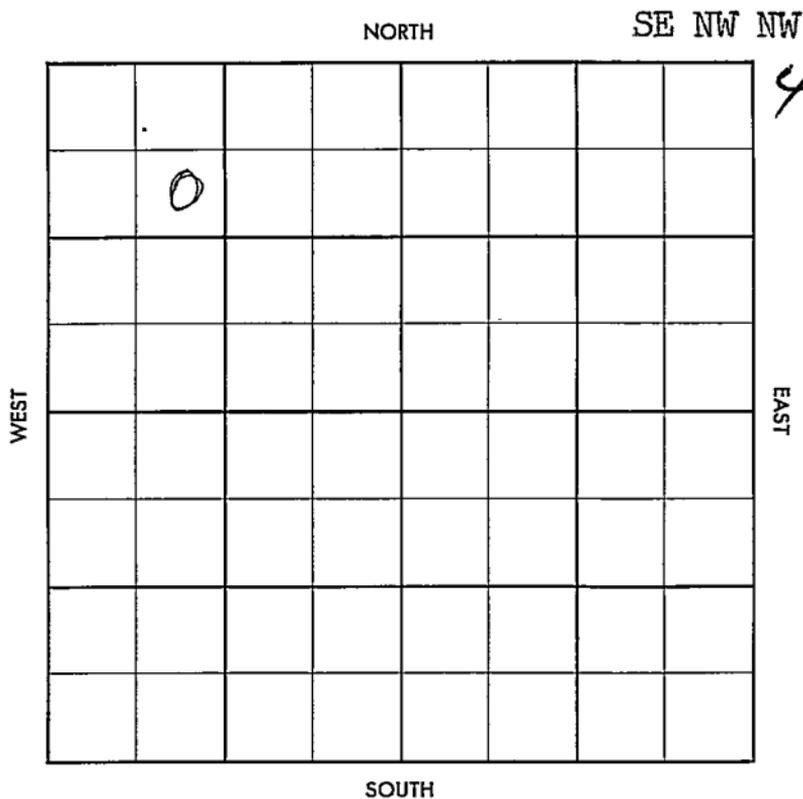

County McPherson Elev. _____
 Sec. 24 Twp. 19 Rge. 2W
 Company Frank Jones
 FarmName Lovett No. 2

TOPS	DEPTH	LOG	DATUM
Anb.			
Tr.			
H.			
Tr.			
Dg.			
Bl.			
L.			
K.C.			
B.K.C.			
Ce.			
C.			
M.			
M.			
K.			
Mz.			
Mo.			
V.			
S.			
S.			
A.			
R.			
Pe.			
G.			
T.D.			

Loc. in Sec. _____
SE NW NW
100' sw of prod
well
 Geol. _____
 Contr. _____
Mallard Tools
 Pool _____
Ritz-Canton

FIRST REPORT
 MAY 29 '51

Date Comm. _____
R U R T

[Handwritten signature]

Co.
 L.S.
 No.
 Sec.
 T.
 R.

Co.

County Lepherston Elev. 1564
 Sec. 24 Twp. 19 Rgs. 2W
 Company Frank Jones
 FarmName Lovett No. 2

TOPS	DEPTH	LOG	DATUM	Loc. in Sec.				
Anh.				SE NW 1/4				
Tp.				100' sw of prod				
H.								
Tr.				well				
Dg.								
Bl.				Geol.				
L.				Contr.				
K.C.				Mallard Tool				
B.K.C.								
Ce.				Pool				
C.								
M.	2917			Ritz-Canton				
M.								
K.				<table border="1"> <tr> <td colspan="2">JUN 26 '57</td> </tr> <tr> <td>o</td> <td></td> </tr> </table>	JUN 26 '57		o	
JUN 26 '57								
o								
Mz.								
Me.				COMPLETE				
V.								
G.								
T.D.	2960							

198

No.

Sec.

T.

R.

Date Comm. R U R T 5-27-57 8575168/100
5 1/2 2953/75 JUN 12 '57 JUN 13 '57
CO DD 2971 S.O. M POP
P. 8 Bopd + 80 Bwpd.