


Section 24 Township 19 Range 2-WWell No. 1 L. MillerCompany H. & M. Drilling

NORTH Ritz Canton Pool

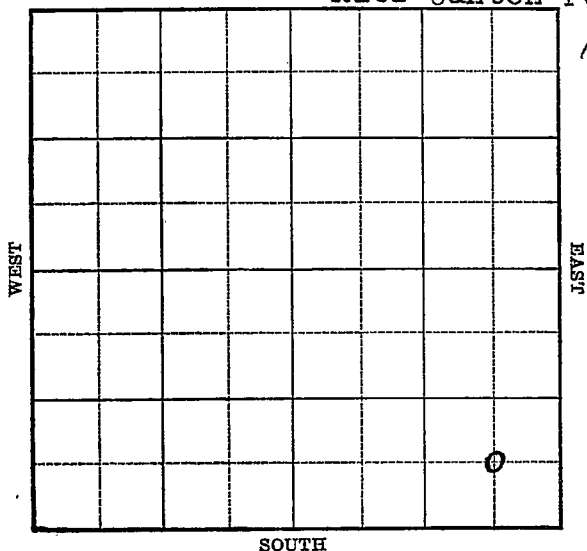

McPherson

Map No. 43 Sec. 24 Twp. 19 R. 2WWell No. 1 L. MillerH & M Drilling Company
was formerly a Lario Lease

Contractor

FIRST REPORT

C SE SE

SECTION PLAT

			0

_____ Ft. from N. Line

660 Ft. from S. Line660 Ft. from E. Line

_____ Ft. from W. Line

RITZ CANTON POOL

Location _____

Rig up _____

Drilling and Remarks:

Cellar

RECORD

Cased _____ in., _____ ft.

Sand _____

Gas _____

Oil _____

Total Depth _____

PRODUCTION

1st 24 hrs. Nat. _____

1st 24 hrs. after shot _____

Gas _____ Cu. Ft.

Dry Hole _____

Abandoned _____

Date

APR 12 1939

19

H. D. Hatfield Scout

McPherson KANSAS

Map No. 43 Sec. 24 Twp. 19 R. 2WWell No. 1 L. MillerH. & M. Drlg. etal Company

Contractor

ABANDONED

C SE SE

 Ft. from N. Line660 Ft. from S. Line660 Ft. from E. Line Ft. from W. Line

RITZ CANTON POOL

SECTION PLAT

			0

Location Rig up

Drilling and Remarks:

*Chas 2917**5" @ 2934**very small GL & B*

RECORD

Cased in., ft.Sand Gas Oil Total Depth 2995

PRODUCTION

1st 24 hrs. Nat. 1st 24 hrs. after shot Gas Cu. Ft.Dry Hole Abandoned

Date

JUN 14 1939

19

S. J. LEWIS

Scout