

McPherson

KANSAS


Form 51-5M-11-31-Palace

Map No. _____ Sec. 24 Twp. 19 R. 2W

Well No. 5. Miller Farm _____

Lario + Shell Company _____

NORTH

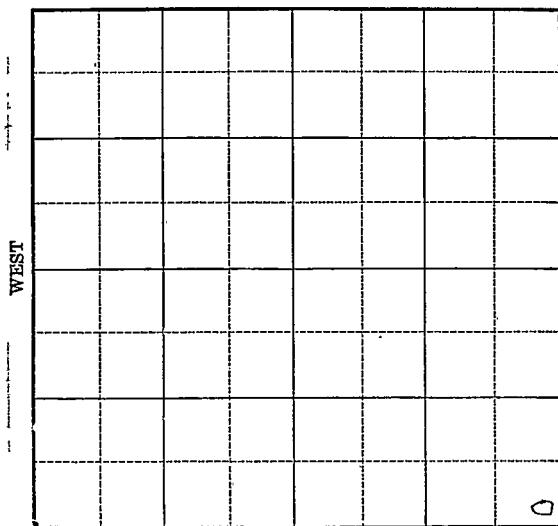

SOUTH

Location _____

Drilling Remarks _____

Rig Up _____

Drilling Remarks _____

RECORD

Cased _____ in. _____ ft.

Sand _____

Gas _____

Oil _____

Total Depth _____

PRODUCTION

1st 24 hrs. Nat. _____

1st 24 hrs. after shot _____

Gas _____ cu. ft. _____

Dry Hole _____

Abandoned _____

Map No. _____ Sec. 24 Twp. 19 R. 2W

Well No. 5 Miller Farm _____


Lario + Shell Company _____

_____ Ft. from N. Line

330 Ft. from S. Line

330 Ft. from E. Line

_____ Ft. from W. Line

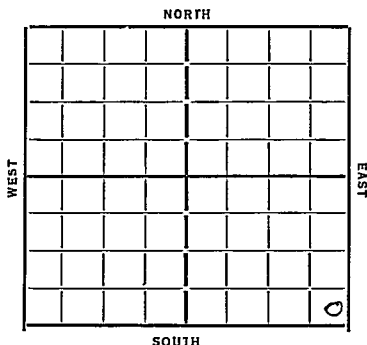

Date
1933

REPORT

7/19 Cellar
7/26 Rgn Up
8/2 dly 557'
8/4 " 1450'
8/17 " 1655'
8/23 T.T.W 2120-30-10" 2145 dly 2250'
8/30 10" 2267 T.C. Lino 2315-1 dly 2530'
9/6 6" 2922-20p chat 2940.T.D
9/13 T.D 3095-446"
9/20 Best Mus Linc 3155 Top Hole 3460 Lowering 5"
9/27 Uola 3410
T.D. 3425 pump 360 bbls
1000 gallon acid

COMPLETED

COMPLETED

Map No. 43 Sec. 24 Twp. 19 R. 2W

Well No. 5 - Miller

Fario & Shell Company

Contractor

SECTION PLAT

.....Ft. from N. Line

330 Ft. from S. Line

330 Ft. from E. Line

.....Ft. from W. Line

FIRST REPORTS

Location.....

Rig up.....

Drilling and Remarks:

clean

RECORD

Cased.....in.,ft.

Sand.....

Gas.....

Oil.....

Total Depth.....

PRODUCTION

1st 24 hrs. Nat.....

1st 24 hrs. after shot.....

Gas.....Cu. Ft.

Dry Hole.....

Abandoned.....

Date

7/19/33 192 Oval Manschreck Scout

McKerison

Map No. 43 Sec. 24 Twp. 19 R. 2W

Well No. 5 - Miller

Paris & Shell Company

Contractor

COMPLETED

SECTION PLAT

Ft. from N. Line

330 Ft. from S. Line

330 Ft. from E. Line

Ft. from W. Line

			0

Location

Rig up

Drilling and Remarks:

1000 gal. acid

pump 360 bbls

RECORD

Cased in. ft.

Sand Hole 3410

Gas

Oil

Total Depth 3425

PRODUCTION

1st 24 hrs. Nat.

1st 24 hrs. after shot

Gas Cu. Ft.

Dry Hole

Abandoned

Date

SEP 27 1933

O. Manscheck