


Section 24 Township 19 S Range 2 W

Well No. # 1 Lovett

Company Frank Jones

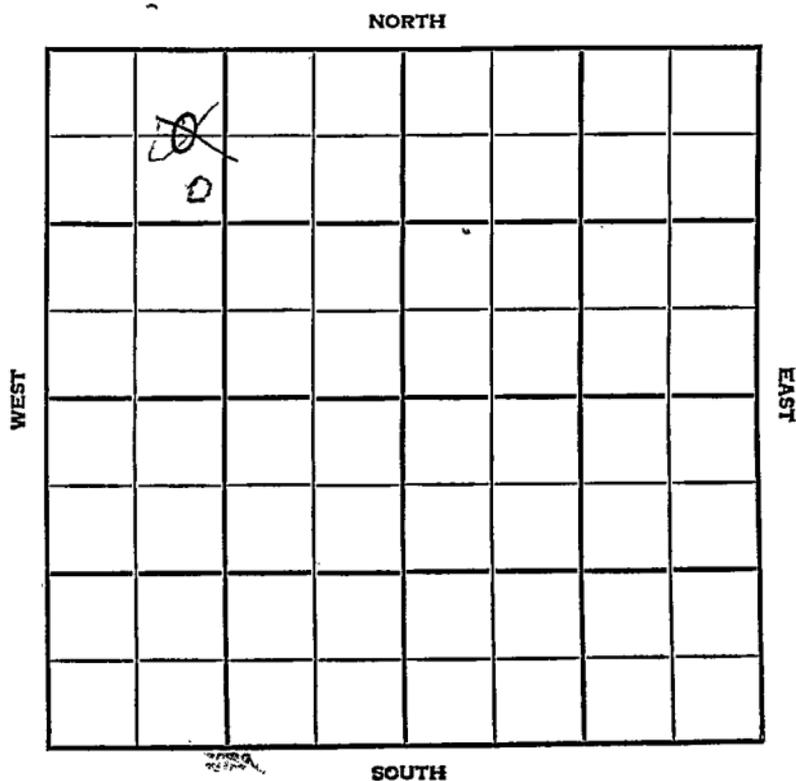

McPherson

KANSAS

SEC. 24	TWP. 19S	R. 2W
------------	-------------	----------


WELL NO. #1 Lovett FARM
COMPANY

CONTRACTOR Frank Jones

Mallard Tools.

Ritz-Canton NORTH

~~800~~
~~660~~ Ft. from N. Line
Ft. from S. Line
Ft. from E. Line
990 Ft. from W. Line

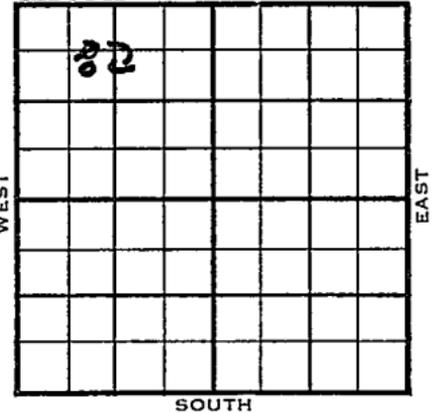

~~55~~
~~6E/2~~ NW NW

1954	ELEVATION	REPORT
------	-----------	--------

12/8 8" @ 156'
WOR.

County McPherson State Kansas

Sec. 24 (Blk. Twp.) 19S (Sur. Rge.) 2W Map No.

Operator Frank Jones

Well No. 1 Farm Lovett

Elev. Location GE/2 NW NW

660 Ft. From N Line

990 Ft. From W Line NW Quarter

Ist. Report DEC 8 1954

Completion

Remarks Mallard tools

Spudding Date

Drlg. Data Ritz-Canton

8" @ 156, WOR

FABEN GILSTRAP

SEC.	TWP.	R.
24	19	2W

WELL NO. 1 Lovett FARM

COMPANY

CONTRACTOR Frank Jones

CORRECTION


SE NW NW

800 FT. FROM N. LINE

_____ FT. FROM S. LINE

_____ FT. FORM E. LINE

990 FT. FROM W. LINE

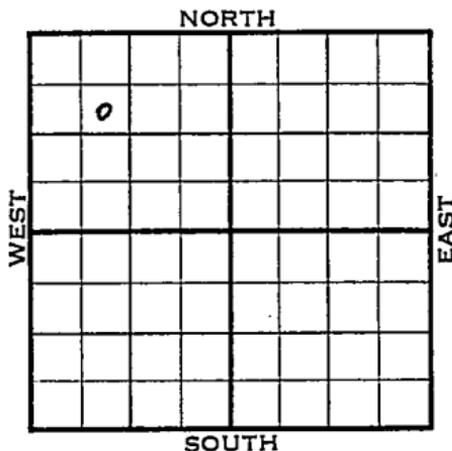

McPherson County

LOCATION

RIG UP

DRILLING AND REMARKS:

Reported

C E $\frac{1}{2}$ NW NW

RECORD	CASED	IN.	FT.
	SAND		
PRODUCTION	GAS		
	OIL		
	TOTAL DEPTH		
	1ST 24 HRS. NAT.		
	1ST 24 HRS. AFTER SHOT		
	GAS		CU. FT.
DRY HOLE			
ABANDONED			

DATE APR 20 1955

SCOUT **FABEN GILSTRAP**