

Form 51-5M-2-29-34703




NORTH

TEST

EAST

SOUTH

Location

Drilling Remarks

Rig Up_____

Drilling Remarks

RECORD

Cased _____ in. _____ ft.

Sand_____

Gas

Oil

Total Depth _____

PRODUCTION

1st 24 hrs. Nat.

1st 24 hrs. after shot.....


Gas _____ cu. ft. _____

Dry Hole

Abandoned.....

Map No. **KANSAS** Sec. *24* Twp. *19* R. *2nd*
 Well No. *1- Lovett* Farm
Jessy Oil Company

 Ft. from N. Line
330 Ft. from S. Line
 Ft. from E. Line
990 Ft. from W. Line
1931

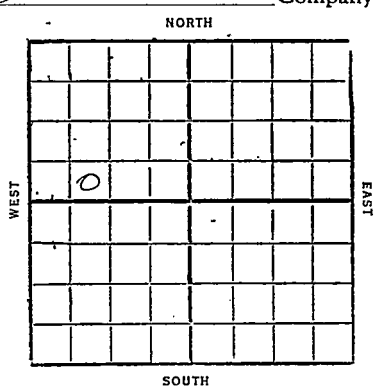

Date	REPORT
<i>12/30</i>	<i>Loc</i>
<i>1932</i>	<i>Bldg rig</i>
<i>1/76</i>	<i>Rig up</i>
<i>1/13</i>	<i>15' 152</i>
<i>1/20</i>	<i>Drlg 1235'</i>
<i>1/27</i>	<i>" 2278'</i>
<i>2/5</i>	<i>" 2875'</i>
<i>2/10</i>	<i>Top Chat 2914</i>
	<i>Base line 3129</i>
	<i>Drlg 3246</i>
<i>2/17</i>	<i>Top Buila 3384-86</i>
	<i>Cem 6"- 3384</i>
	<i>Prest</i>
<i>2/26</i>	<i>TD 3386 drlg cement</i>
<i>3/2</i>	<i>TD 3394</i>
	<i>2500' oil in hole</i>
<i>3/9</i>	<i>TD 3394</i>
	<i>swab 75 bbl 3 hrs</i>
<i>3/16</i>	<i>TD 3394</i>
	<i>swab 30 bbl per hour</i>
	<i>Well shoot</i>

- 3/22- T.D. 3399' Viola
swab 30 to 35 bbls
per hour
- 3/30- Top Viola 3384
T.D. 3401
shot 10 qt 3386-96
swab 35 to 40 bbls
oel per hour
- 4/6- T.D. 3401
swab 855 bbl 24 hr
- 4/13- S.D. 3401' T.D.
- 4/20- T.D. 3401
Prep to take potential
- 4/27 —
- 5/4 —
- 5/11- T.D. 3401
Pump 486 bbl 6 hrs
- 5/18- T.D. 3401 No potential
- 5/25- Cased 6"-3384
Viola 3384-3401
T.D. 3401
shot 10 qt 3386-96
Potential prod
1022 bbl
Comp.

McPherson

43 KANSAS

Map No. _____ Sec. 24 Twp. 19 R. 2

Well No. 1 - Louisa

Gypsy Oil Co. Company

Contractor

FIRST REPORTS

_____ Ft. from N. Line

330 Ft. from S. Line

_____ Ft. from E. Line

990 Ft. from W. Line

SECTION PLAT

0			

Location ✓

Rig up

Drilling and Remarks:

RECORD

Cased _____ in., _____ ft.

Sand _____

Gas _____

Oil _____

Total Depth _____

PRODUCTION

1st 24 hrs. Nat. _____

1st 24 hrs. after shot _____

Gas _____ Cu. Ft.

Dry Hole _____

Abandoned _____

Date

DEC 30 1931

192 CHAS. L. SHERWOOD

Scout

Worcester

Returned	<i>[Signature]</i>
Cards	<i>[Signature]</i>
Tracing	<i>[Signature]</i>
France Map	<i>[Signature]</i>
Scarborough Map	<i>[Signature]</i>
Moody Map	<i>[Signature]</i>
Scarborough Plat Book	<i>[Signature]</i>
Moody Plat Book	<i>[Signature]</i>

McPherson

43 KANSAS

Map No. _____ Sec. 24 Twp. 19 R. 2

Well No. 1 Louett

Gypsy Oil Co

Company

Contractor

COMPLETED

SECTION PLAT

0			7

_____ Ft. from N. Line

330 _____ Ft. from S. Line

_____ Ft. from E. Line

990 _____ Ft. from W. Line

Location _____

Rig up _____

Drilling and Remarks:

Shot 10/3386-96

Potential Prod

1022 Bbls.

RECORD

Cased 6" in. 3384 ft.

Sand 3384-3401

Gas _____

Oil _____

Total Depth 3401

PRODUCTION

1st 24 hrs. Nat. _____

1st 24 hrs. after shot _____

Gas _____ Cu. Ft.

Dry Hole _____

Abandoned _____

Date

MAY 25 1932

CHAS. L. SHERWOOD

192

Scout

Water

Returned	<i>[Signature]</i>
Cards	<i>[Signature]</i>
Tracing	<i>[Signature]</i>
France Map	<i>[Signature]</i>
Scarborough Map	<i>[Signature]</i>
Moody Map	<i>[Signature]</i>
Scarborough Flat Book	
Moody Flat Book	