


McPherson

Form 51-5M-11-31-Palace

Map No. **KANSAS** Sec. 24 Twp. 19 R. 2W

Well No. 1-A Lovett Farm
Helmreich & Payne et al Company

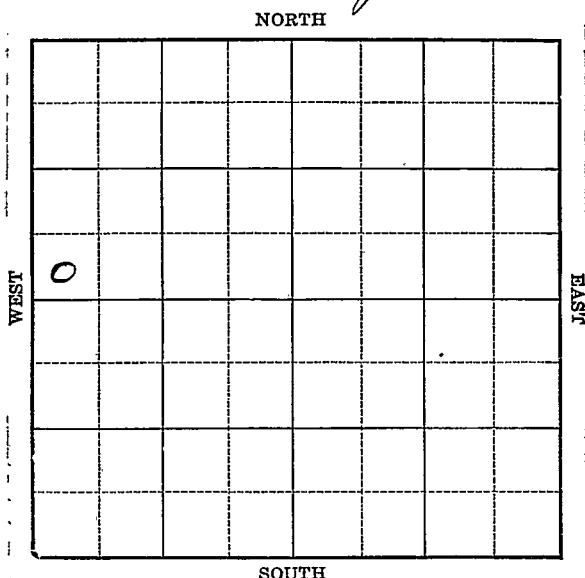

Location

Drilling Remarks

Rig Up

Drilling Remarks

RECORD

Cased in. ft.

Sand

Gas

Oil

Total Depth

PRODUCTION

1st 24 hrs. Nat.

1st 24 hrs. after shot

Gas cu. ft.

Dry Hole

Abandoned


Mc Pherson

Map No. **KANSAS** Sec. 24 Twp. 19 R. 2 WWell No. 1-A Lovett FarmHelmerick & Payne et al Company

Ft. from N. Line

330 Ft. from S. Line

Ft. from E. Line

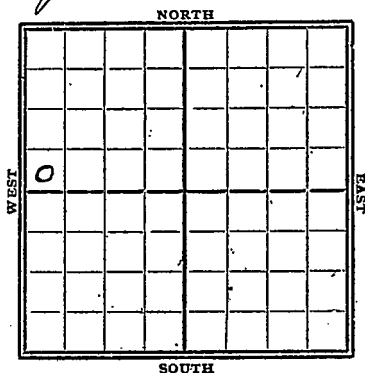380 Ft. from W. Line

Date

REPORT

1934
 4/4 Location
 4/12 Moving in
 4/19 Dlg 630 13" 137
 4/26 " 2895 K.C.L. 2335
 5/3 Chet 2903 Viola 3397 3391
 7" 3398 TD 3400 Rust
 5/10 —
 5/18 Drilling
 5/25 Correct Viola 3391 TD 3397
 1000 Gal acid
 5/31 25 Bbls oil & 5 bbls water
 8 hrs.
 6/7 Testing
 6/14 — 6/21 —
 6/28 Shot 10 gts 3395-99 -
 7/5 2000 acid
 7/11 Viola 3391 TD 3414
 1000 acid 15 Bbls.

COMPLETED

Map No. 43 Sec. 24 Twp. 19 R. 2WWell No. 1A LovettHelmerick & Payne et al Company

Contractor

FIRST REPORT

SECTION PLAT

0			

 Ft. from N. Line330 Ft. from S. Line Ft. from E. Line380 Ft. from W. LineLocation ✓Rig up

Drilling and Remarks:

RECORD

Cased in., ft.Sand Gas Oil Total Depth

PRODUCTION

1st 24 hrs. Nat. 1st 24 hrs. after shot Gas Cu. Ft.Dry Hole Abandoned

Date

4-4-37 19O. Marmaschuk Scout

Map No. 43 Sec. 24 Twp. 19 R. 2WWell No. 1-A-LovettHelmerick & Payne Company

Contractor

COMPLETED

SECTION PLAT

0			

_____ Ft. from N. Line

330 Ft. from S. Line

_____ Ft. from E. Line

380 Ft. from W. Line

Location _____

Rig up _____

Drilling and Remarks:

1000 acid15 lbs.

RECORD

Cased _____ in., _____ ft.

Sand Viola 3391

Gas _____

Oil _____

Total Depth 3414

PRODUCTION

1st 24 hrs. Nat. _____

1st 24 hrs. after shot _____

Gas _____ Cu. Ft.

Dry Hole _____

Abandoned _____

Date

7-11-37 19 D. Mammick Scout