


Section 24 Township 19 Range 2W

Well No. #6 Miller

Company Geo. Hess & H.C. Bennett

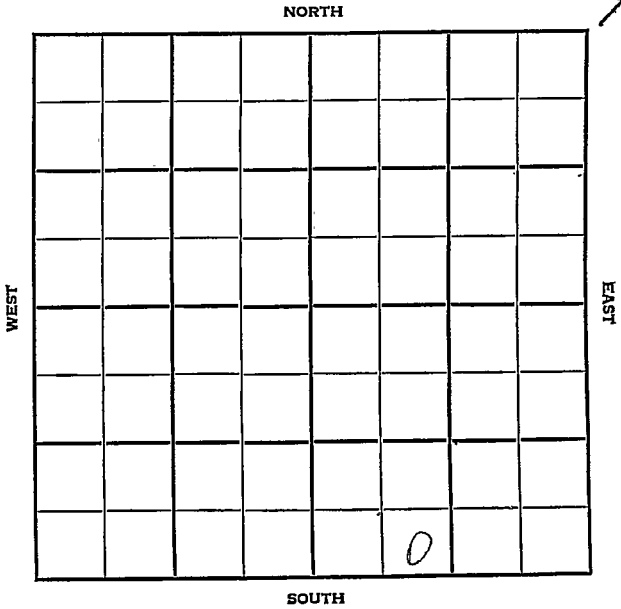

County McPherson Elev. _____
 Sec. 21 Twp. 19 Rge. 2W
 Company Geo. Hess & H. C. Bennett
 FarmName Miller No. 6

TOPS

DEPTH

LOG

DATUM

Loc. in Sec.

Anh.

SE SW SE

Tp.

H.

Tr.

Dg.

Bl.

L.

K.C.

B.K.C.

Ce.

C.

M.

M.

K.

Mz.

Me.

V.

S.

S.

A.

R.

P.E.

G.

T.D.

Geol.

Contr.

Mallard

Pool

Ritz-Canton

FIRST REPORT	
IAN 9 '57	0

Date Comm. 7-2-57811 @ 755 drlg. 2650

County McPherson Elev. _____
 Sec. 21 Twp. 19 Rge. 2W
 Company Geo. Hess & H. C. Bennett
 Farm Name Miller No. 6

TOPS	DEPTH	LOG	DATUM	Loc. in Sec.
Anh.				SE SW SP
Ip.				
H.				
Tr.				
Dg.				
Bl.				
L.				Geol.
K.C.	2310			Contr.
B.K.C.				Mallard
Ce.				Pool
C.				Pitz-Canton
M.	2926			
M.				
K.				
Mz.				
Mo.				
V.				
S.				
S.				
A.				
R.				
Pe.				
G.				
T.D.	2964			

Date Comm. 1-2-578" @ 155 drlg. 2650 15' 51" 5 1/2 2962JAN '57 CO 2964 $\pm$ 15 BO + 20

Bwpd Pop. P. 15 BO + 20.

Bwpd.