


Section 24 Township 19 Range 2WWell No. #5 MillerCompany Geo. Hess & H. Bennett

NORTH

WEST

EAST

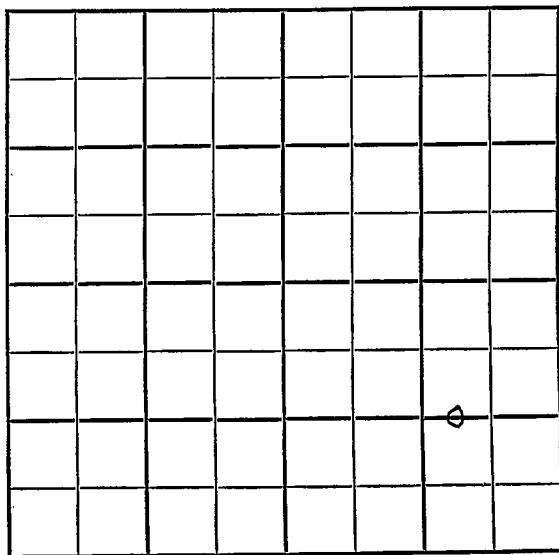

SOUTH

McPherson KANSAS

SEC.	TWP.	R.
24	19	2W

WELL NO.

5 Miller

FARM

COMPANY

Geo. Hess & H. Bennett

CONTRACTOR

Mallard


Ritz-Canton Pool

_____ Ft. from N. Line

1320 _____ Ft. from S. Line

990 _____ Ft. from E. Line

_____ Ft. from W. Line

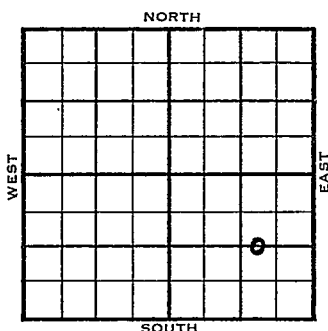

C W/2 E/2 SE

1955	ELEVATION	REPORT
	1560'	

2/16 -


MIR

3/16

Spud 2-21-55 Oil Well TD 2965
 8" @ 157 Miss 2952 TD 2954
 5" @ 2952 DD 2965 frac
 Comp. 15 BOPD 90 BW

COMPLETED

County **McPherson** State **Kansas**
 Sec. **24** (Blk. Twp.) **19** (Sur. Rge.) **2W** Map No.
 Operator **Geo. Hess & H. Bennett**
 Well No. **5** Farm **Miller**
 Elev. Location **C W $\frac{1}{2}$ E $\frac{1}{2}$ SE**

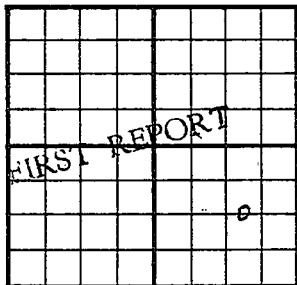

1320 Ft. From **S** Line **SE**

990 Ft. From **E** Line Quarter

1st. Report **FEB 1 6 1955**

Completion

Remarks

Mallard - Contr.


Spudding Date

Drlg. Data

Ritz-Canton Pool

M I R

FABEN GILSTRAP

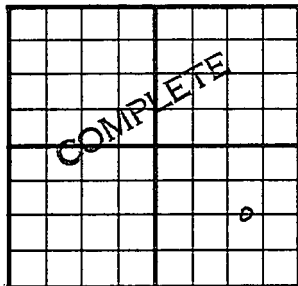County McPherson State KansasSec. 24 (Blk.) 19 (Sur.) 2W Map No.Operator Geo. Hess & H. BennettWell No. 5 Farm MillerElev. 1560 Location C W $\frac{1}{2}$ E $\frac{1}{2}$ SE1320 Ft. From S Line SE990 Ft. From E Line Quarter

1st. Report

Completion MAR 1 6 1955Remarks Ritz-Canton PoolMallard - Contr.Spudding Date 2-21-55Drilg. Data Oil well TD 29658" @ 157 Miss. 2952 TD 29545" @ 2952 DD 2965 fracComp. 15 bopd 90 bw

FABEN GILSTRAP