

Section 24 Township 19 Range 2W


Well No. #3 Miller

Company Hass & Bennett

Ritz-Canton Pool

NORTH

10

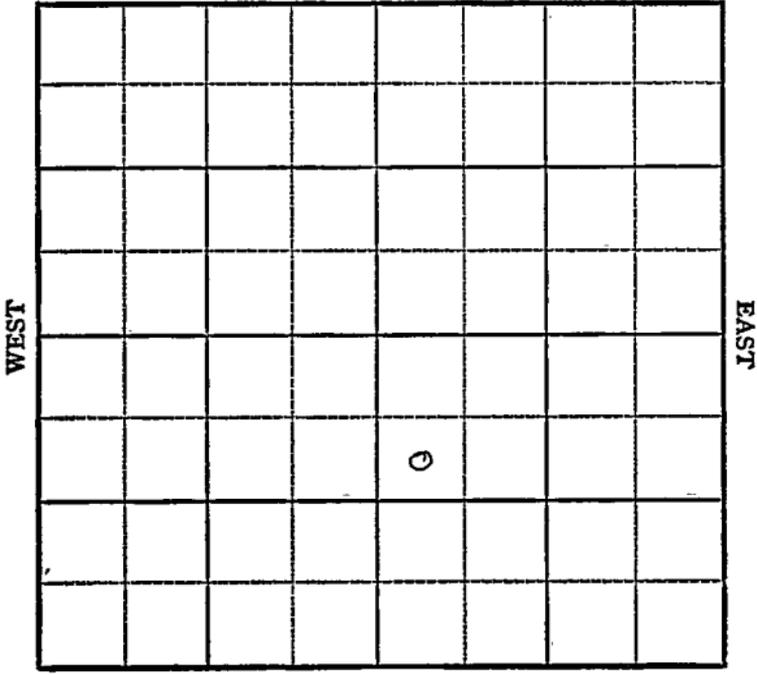

SOUTH

Sec. 24 Twp. 19 R. 2-W

Well No. #3 Miller Farm
Hess & Bennett Company
Ritz-Canton


990 Ft. from N. Line

_____ Ft. from S. Line

_____ Ft. from E. Line

330 Ft. from W. Line

SW NW SE

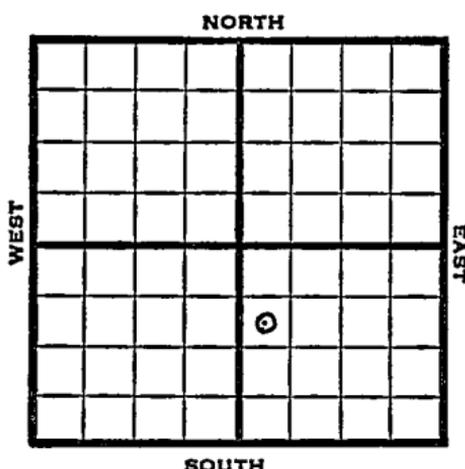

1948

Eli 1552'

R E P O R T

10/13

8" @ 135

10/19

Drlg 630'
Drlg 3395'

10/26

Chat 2923'
TD 3406'
5" @ 3007'

11/3

"

11/10

"

11/16

"

11/23

"

12/1

TD 3406'
Chat 2923'
Viola 3400'
5" @ 3007'
Perf chat
Pump 10 oil / 20 W Pot
38° Gr.
Comp

COMPLETED

Map No. _____ Sec. 24 Twp. 19 R. 2W

Well No. 3 Miller

Hess & Bennett Company

FIRST REPORT Contractor

SW NW SE

SECTION PLAT

990 Ft. from N. Line

_____ Ft. from S. Line

_____ Ft. from E. Line

330 Ft. from W. Line

McPherson County

RECORD

Location _____

Rig up _____

Drilling and Remarks:

8" @ 135

drlg. 630

Cased _____ in., _____ ft.

Sand _____

Gas _____

Oil _____

Total Depth _____

PRODUCTION

1st 24 hrs. Nat. _____

1st 24 hrs. after shot _____

Gas _____ Cu. Ft.

Dry Hole _____

Abandoned _____

Date

OCT 13 1948 19

S. J. LEWIS Scout

Kansas

Map No. 43 Sec. 24 Twp. 19 R. 2WWell No. 3 MillerHess & Bennett Company

COMPLETE

Contractor

SW NW SE

E 1, 1552
SECTION PLAT990 Ft. from N. Line

_____ Ft. from S. Line

_____ Ft. from E. Line

330 Ft. from W. Line

McPherson County

Location _____

Rig up _____

Drilling and Remarks:

Cha 72923Vid low 4005" @ 3007Perf ChartProd 10 oil + 20 WOB25' - 28'

RECORD

Cased _____ in., _____ ft.

Sand _____

Gas _____

Oil Total Depth 3406

PRODUCTION

1st 24 hrs. Nat. _____

1st 24 hrs. after shot _____

Gas _____ Cu. Ft.

Dry Hole _____

Abandoned _____

Date

DEC 1 1948 19S. J. LEWIS Scout