

KANSAS


FORM 51 5M 6-46 PETROL

McPherson county

Section 24 Township 19 Range 2-W

Well No. #2, J. M. Miller

Company Hess and Bennett

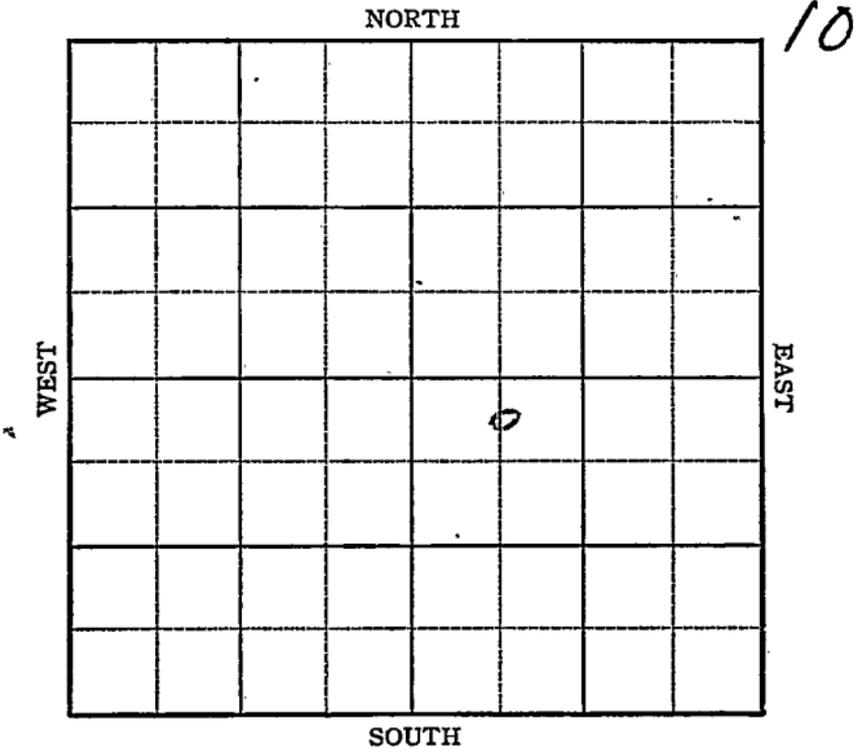

Sec. 24 Twp. 19 R. 2W

Well No. 2 J. M. Miller Farm

Hess & Bennett Company


Ritz-Canton

400 Ft. from N. Line

Ft. from S. Line

Ft. from E. Line

810 Ft. from W. Line

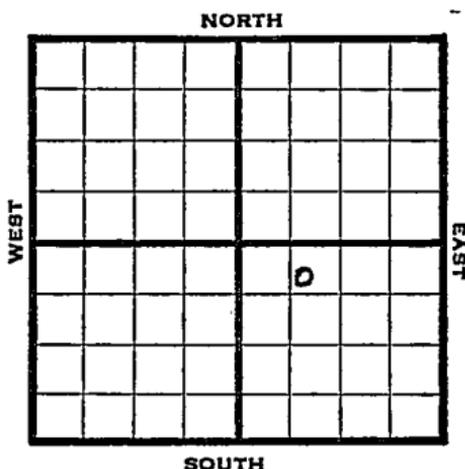

C N L NW SE

1946 Elev. 1558' REPORT

11/20	RUR
11/27	10" @ 100' Drlg 1020'
12/3	Miss 2925-58 TD 7" @ 2948', RUST
12/10	TD 2982'
12/17	"
1947	
1/2	Miss 2925' 7" @ 2948' TD 2982' Pump 20 oil plus 10 W POT 39 Grav.

COMPLETED

Kansas **KANSAS**Map No. 43 Sec. 24 Twp. 19 R. 2WWell No. 2 J. M. MillerHess & Bennett

Company

(COMPLETED)

Contractor

C N L NW SE

E1, 1558
SECTION PLAT400 Ft. from N. Line

_____ Ft. from S. Line

_____ Ft. from E. Line

810 Ft. from W. Line

		o	

McPherson County

Location _____

Rig up _____

Drilling and Remarks:

Miss 2925
7" @ 2945
Pumped oil
10 W 1st.

2925**RECORD**

Cased _____ in., _____ ft.

Sand _____

Gas _____

Oil _____

Total Depth 2982**PRODUCTION**

1st 24 hrs. Nat. _____

1st 24 hrs. after shot _____

Gas _____ Cu. Ft.

Dry Hole _____

Abandoned _____

Date

JAN 2 1947 19S. J. LEWIS

Scout