


Map No. KANSAS Sec. 24 Twp. 19 R. 2^w

Well No. 1- Muller Farm
Lario et al Company

330 Ft. from N. Line
____ Ft. from S. Line
330 Ft. from E. Line
____ Ft. from W. Line
1931

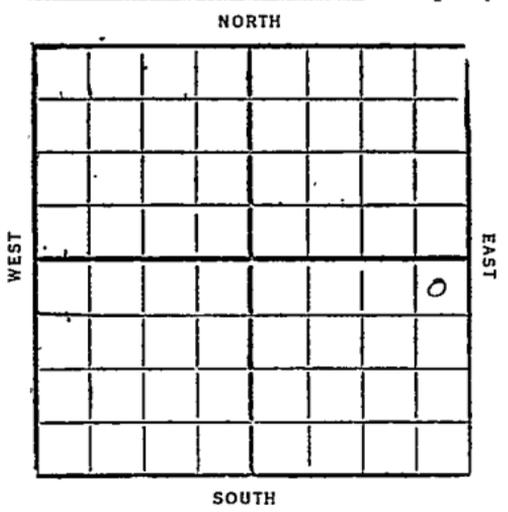

Date	REPORT
5/13	Cellar
5/20	Bldg rig
5/27	
6/3	drlg 750'
6/10	" 1835'
6/17	10" - 2246
	drlg 2320'
6/24	" 2790'
7/1	Top chat 2915
	8" - 2917
	drlg 3045
7/8	" 3125'
7/15	Viola 3394-3405
	TD 3405
	3256 lbl oil
	Potential
	Comp.

McPherson

43 KANSAS Sec. *7H* Twp. *19* R. *2* *W*

Well No. *1 Miller*

Laird et al Company

Contractor

FIRST REPORTS

330 Ft. from N. Line

..... Ft. from S. Line

330 Ft. from E. Line

..... Ft. from W. Line

SECTION PLAT

			○

Location

Rig up *Cellar.*

Drilling and Remarks:

RECORD

Cased.....in.,ft.

Sand.....

Gas.....

Oil.....

Total Depth.....

PRODUCTION

1st 24 hrs. Nat.....

1st 24 hrs. after shot.....

Gas.....Cu. Ft.

Dry Hole.....

Abandoned.....

Date

MAY 13 1931

CHAS. L. SHERWOOD

192.....Scout

McPherson

KANSAS
 Map No. *43* Sec. *24* Twp. *19* R. *2* W
 Well No. *1* *Miller*
Lario *Co* Company

Company

Contractor

COMPLETE

SECTION PLAT

330 Ft. from N. Line

..... Ft. from S. Line

330 Ft. from E. Line

..... Ft. from W. Line

			o

Location.....

Rig up.....

Drilling and Remarks:

Potential

3256 Bls.

RECORD

Cased..... in. ft.

Sand *Udall 3394-3405*

Gas.....

Oil.....

Total Depth *3405*

PRODUCTION

1st 24 hrs. Nat.

1st 24 hrs. after shot.....

Gas..... Cu. Ft.

Dry Hole.....

Abandoned.....

Date

JUL 15 1931

CHAS. L. SHERWOOD

192

Scout