

KANSAS

m. Pherson

Form 51-5M-2-29-34703

Map No. _____ Sec. *24* Twp. *19* R. *2^w*


Well No. *4 Miller* Farm

Lario-Shell Company

NORTH

WEST

EAST

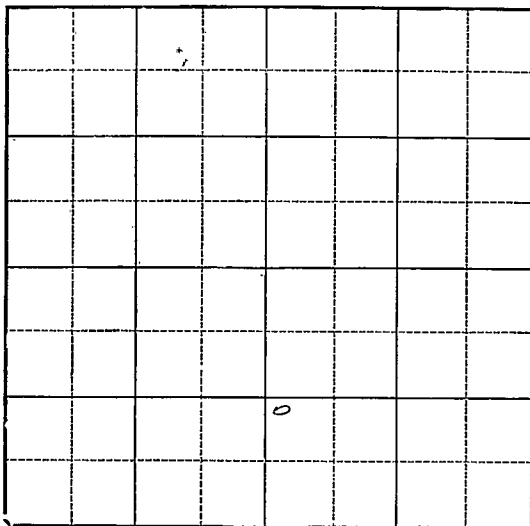

15

SOUTH

Location _____
Drilling Remarks _____

Rig Up _____
Drilling Remarks _____

RECORD
Cased _____ in. _____ ft.
Sand _____
Gas _____
Oil _____
Total Depth _____

PRODUCTION
1st 24-hrs. Nat. _____
1st 24 hrs. after shot _____
Gas _____ cu. ft.
Dry Hole _____
Abandoned _____

McPherson

Map No. _____ Sec. 24 Twp. 19 R. 2 W

Well No. 4 Miller Farm
Lario & Shell Company


_____ Ft. from N. Line

990' Ft. from S. Line

_____ Ft. from E. Line

330' Ft. from W. Line

1932

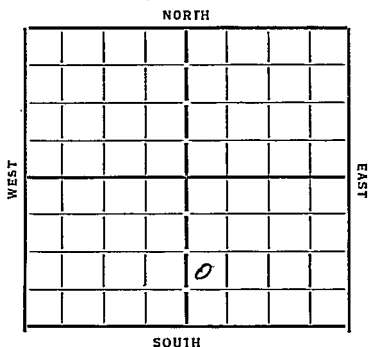

Date	REPORT
3/29	Cellar + Pond
4/4	Rig
4/12	Rigging up
4/19	Wells 1755'
4/26	Shot 2919' Cement 8" 3100' R4S, I
5/4	Cement 8" 2995' Run 3296
5/10	Bailing
5/17	Barrel line 3125-6" 3373 Viola 3379-3393 swab 11 bbls per hr not shot 15 gts 3383-91 No test
5/24	Sand Viola 3379-93 T.D. 3393 Shot 15 gts 3383-91 Pump 948 bbls 24 hours (Completed)

McPherson
 43 KANSAS
 Map No. _____ Sec. 24 Twp. 19 R. 2^W

Well No. 4 *Miller*
Lario & Shell Company

Contractor

FIRST REPORTS

SECTION PLAT

_____ Ft. from N. Line

990 Ft. from S. Line

_____ Ft. from E. Line

330 Ft. from W. Line

		0	

Location _____

Rig up _____

Drilling and Remarks:

Cellar & Pond

RECORD

Cased _____ in., _____ ft.

Sand _____

Gas _____

Oil _____

Total Depth _____

PRODUCTION

1st 24 hrs. Nat. _____

1st 24 hrs. after shot _____

Gas _____ Cu. Ft.

Dry Hole _____

Abandoned _____

Date

MAR 29 1933

192. CHAS. L. SHERWOOD

Scout

McPherson

43 KANSAS Map No. Sec. 24 Twp. 19 R. 2

Well No. 4 Miller
Lario & Dhev Company

Contractor

COMPLETED

SECTION PLAT

Ft. from N. Line

990 Ft. from S. Line

Ft. from E. Line

330 Ft. from W. Line

		0	

Location

Rig up

Drilling and Remarks:

Shot 15/3383-91

Pump 948
Bls 24 hours

RECORD

Cased 6 in., 3373 ft.

Sand 3379-93

Gas

Oil

Total Depth 3393

PRODUCTION

1st 24 hrs. Nat.

1st 24 hrs. after shot

Gas Cu. Ft.

Dry Hole

Abandoned

Date

MAY 24 1933

CHAS. L. SHERWOOD

Scout