


Map No. KANSAS Sec. 24 Twp. 19 R. 2 ^W
 Well No. 3 Miller Farm
Lario & Shell Company

16

NORTH

WEST

EAST

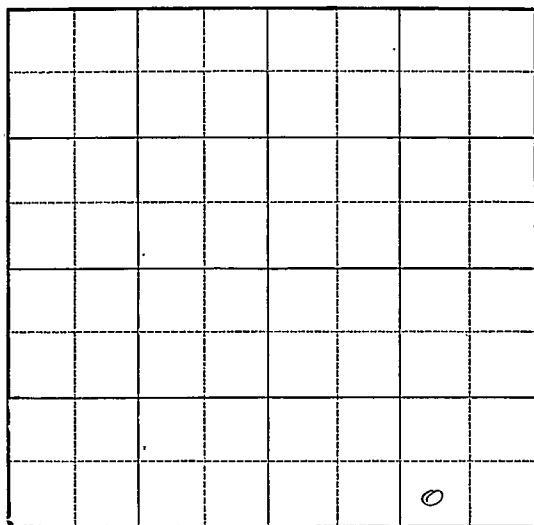

SOUTH

Location _____
 Drilling Remarks _____

Rig Up _____
 Drilling Remarks _____

RECORD
 Cased _____ in. _____ ft.
 Sand _____
 Gas _____
 Oil _____
 Total Depth _____

PRODUCTION
 1st 24 hrs. Nat. _____
 1st 24 hrs. after shot _____
 Gas _____ cu. ft.
 Dry Hole _____
 Abandoned _____

McPherson

Form 252-A
5M 4-32 MPC

KANSAS

Map No. _____ Sec. 24 Twp. 19 R. 2W

Well No. 3-Miller Farm _____


Larus + Shell Company _____

_____ Ft. from N. Line

330 Ft. from S. Line

990 Ft. from E. Line

_____ Ft. from W. Line

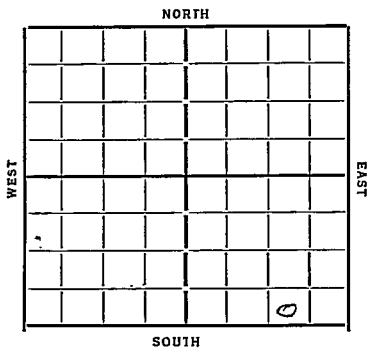

Date
1933

REPORT

7/12 Rig
7/19 20" 78 Run 15 1/2 548'
7/26 15" 548 show gas 675 dily 1370'
8/2 dily 2080
8/9 " 2490'
8/17 —
8/23 Top Chit 2921-8" 2927 dily 2020'
8/30 6" 3092 B.L. 3130 Top Viola 3338 Run 5"
9/6 Comp Top Viola 3338
9/20 T.D. 3417 480 bbls

COMPLETED

Map No. 43 Sec. 24 Twp. 19 R. 2WWell No. 3 - MillerLario + Shell Company

Contractor

SECTION PLAT

			0

Ft. from N. Line

330 Ft. from S. Line990 Ft. from E. Line

Ft. from W. Line

~~COMPLETED~~

Location

Rig up

Drilling and Remarks:

480 bbls

RECORD

Cased in, ft.

Sand Viola 3338

Gas

Oil

Total Depth 3417

PRODUCTION

1st 24 hrs. Nat.

1st 24 hrs. after shot

Gas Cu. Ft.

Dry Hole

Abandoned

Date

7/6/33 1932 O. Mansbach

KANSAS

Map No. _____ Sec. 24 Twp. 19 R. 2WWell No. 43 3-MillerParis & Shell Company

Contractor _____

SECTION PLAT

			0

_____ Ft. from N. Line

330 Ft. from S. Line990 Ft. from E. Line

_____ Ft. from W. Line

FIRST REPORTS

Location _____

Rig up _____

Drilling and Remarks:

Rig

RECORD

Cased _____ in., _____ ft.

Sand _____

Gas _____

Oil _____

Total Depth _____

PRODUCTION

1st 24 hrs. Nat. _____

1st 24 hrs. after shot _____

Gas _____ Cu. Ft.

Dry Hole _____

Abandoned _____

Date

7/12/33 192 Oval Mannschreck Scout