


Map No. KANSAS Sec. 24 Twp. 19 R. 2^w

Well No. 1-Boyl Farm

Lario & Shell Company

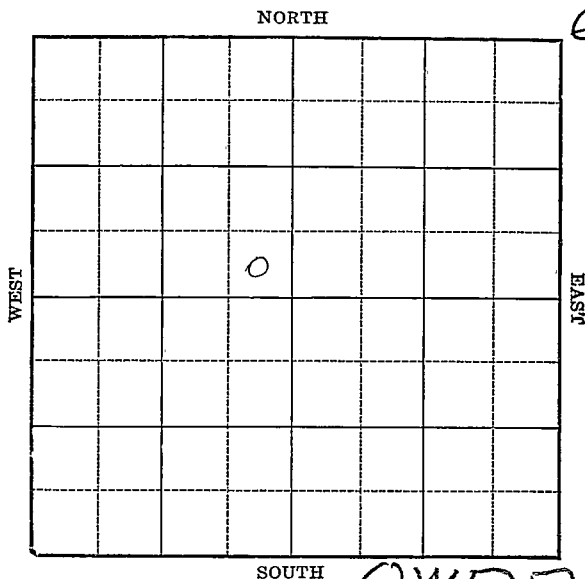

Location _____

Drilling Remarks _____

RECORD

Cased _____ in. _____ ft.

Sand _____

Gas _____

Oil _____

Total Depth _____

Rig Up _____

Drilling Remarks _____

PRODUCTION

1st 24 hrs. Nat. _____

1st 24 hrs. after shot _____

Gas _____ cu. ft.

Dry Hole _____

Abandoned _____

Map No. KANSAS Sec. 24 Twp. 19 R. 2^W

Well No. 1 - Boal Farm
Lario & Shell Company

NORTH


 Ft. from N. Line

330 Ft. from S. Line

330 Ft. from E. Line

 Ft. from W. Line

1931

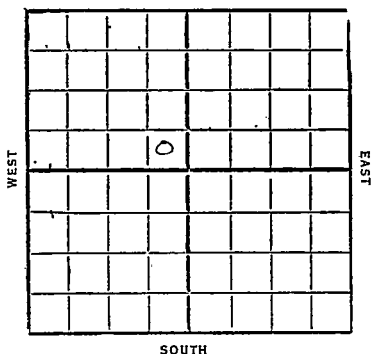

Date

REPORT

1/21	Loc
1/28	Bldg rig
2/4	Stand
2/11	Drlg 1240'
2/18	" 1405'
2/25	" 2270'
3/4	Top Chat 2912
	Run 6"
3/11	Drlg 2920
	3 1/2 ft gas
	900 # R.P.
3/18	Chat 2912-48
	T.D. 2948
	4 1/2 ft gas
	Comp.
1931	OWDD
8/19	Old T.D. 2948
	Rgn up
8/26	
9/2	T.D. 3080' UIR 6"
9/19	Top Viola 3390
	drlg 3391 good show

9/16- TD. 3395'
swab 425 bbl 5 hr
SD for pipe line

9/23 —

9/30 —

10/7- TD. 3395' No test

10/14- Viola 3390-98

TD. 3398

Shot 20 gpt 3390-96
1483 bbl all

Potential gauge
Comp

Map No. **KANSAS** Sec. 24 Twp. 19 R. 2 W

Well No. 43 Boab

Lewis & Shell Company

Contractor

SECTION PLAT


Ft. from N. Line

330 Ft. from S. Line

330 Ft. from E. Line

Ft. from W. Line

COMPLETED

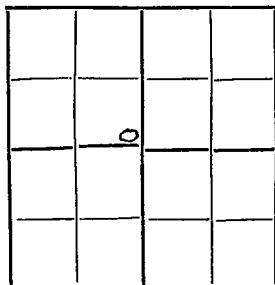

Location

Rig up

Drilling and Remarks:

RECORD

Cased in, ft.

Sand 2912 - 48

Gas 4 1/2

Oil

Total Depth 2948

PRODUCTION

1st 24 hrs. Nat.

1st 24 hrs. after shot

Gas Cu. Ft.

Dry Hole

Abandoned

Date

MAR 18 1931

S. J. LEWIS Scout


Journal
Moody

Returned	<i>TRB</i>
Cards	
Tracing	<i>CRK</i>
France Map	<i>X</i>
Scarborough Map	<i>MB</i>
Moody Map	<i>X</i>
Scarborough Plat Book	
Moody Plat Book	

Map No. KANSAS Sec. 24 Twp. 19 R. 2WWell No. 1 BoalLewis & Shell Company

Contractor

SECTION PLAT

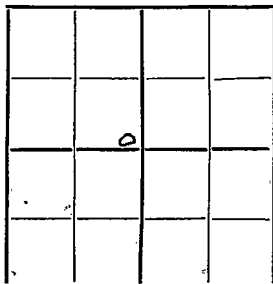

Ft. from N. Line

830 Ft. from S. Line830 Ft. from E. Line

Ft. from W. Line

FIRST REPORTS

Location ✓

Rig up

Drilling and Remarks:

RECORD

Cased in., ft.

Sand

Gas

Oil

Total Depth

PRODUCTION

1st 24 hrs. Nat.

1st 24 hrs. after shot

Gas Cu. Ft.

Dry Hole

Abandoned

Date

JAN 21 1931
192S. J. LEWIS Scout

*James
Moody*

Returned	<i>EB</i>
Cards	<i>EB</i>
Tracing	<i>EB</i>
France Map	<i>X</i>
Scarborough Map	<i>X</i>
Moody Map	<i>X</i>
Scarborough Flat Book	<i>X</i>
Moody Flat Book	<i>X</i>

McPherson

 Map No. KANSAS Sec. 24 Twp. 19 R. 2 W
43 1 Boal
 Well No.

Lario & Shee Company

Contractor

FIRST REPORTS

SECTION PLAT

Ft. from N. Line

330 Ft. from S. Line

330 Ft. from E. Line

Ft. from W. Line

	0		

"OW DD"

Location

 Rig up 60 JD 2948

Drilling and Remarks:

Rigging up

RECORD

Cased _____ in., _____ ft.

Sand _____

Gas _____

Oil _____

Total Depth _____

PRODUCTION

1st 24 hrs. Nat. _____

1st 24 hrs. after shot _____

Gas _____ Cu. Ft.

Dry Hole _____

Abandoned _____

Date

AUG 1 9 1931

CHAS. L. SHERWOOD

192

Scout

James Wood
W. W. Wood

Returned	_____
Cards	_____
Tracing	_____
France Map	_____
Scarborough Map	_____
Moody Map	_____
Scarborough Plat Book	_____
Moody Plat Book	_____

MSP Heron

43 KANSAS Map No. Sec. 24 Twp. 19 R. 2 W

Well No. 1 Boar

Lario & Shell Company

Contractor

COMPLETED

SECTION PLAT

Ft. from N. Line

330 Ft. from S. Line

330 Ft. from E. Line

Ft. from W. Line

	o		

Location

RECORD

Rig up

Drilling and Remarks.

Cased in. ft.

Sand Hole 3390-98

Gas

Oil

Total Depth 3398

Potential

1483 Blo.

Date

OCT 1 1931 CHAS. L. SHERWOOD

192

Scout

[Handwritten signature]

[Handwritten signature]

Returned	<i>[Signature]</i>
Cards	<i>[Signature]</i>
Tracing	<i>[Signature]</i>
France Map	<i>[Signature]</i>
Scarborough Map	<i>[Signature]</i>
Moody Map	<i>[Signature]</i>
Scarborough Plat Book	<i>[Signature]</i>
Moody Plat Book	<i>[Signature]</i>