


DX 78-1

Section 24 Township 19 Range 2 W
Well No. #1 Gratton
Company Geo. Hess

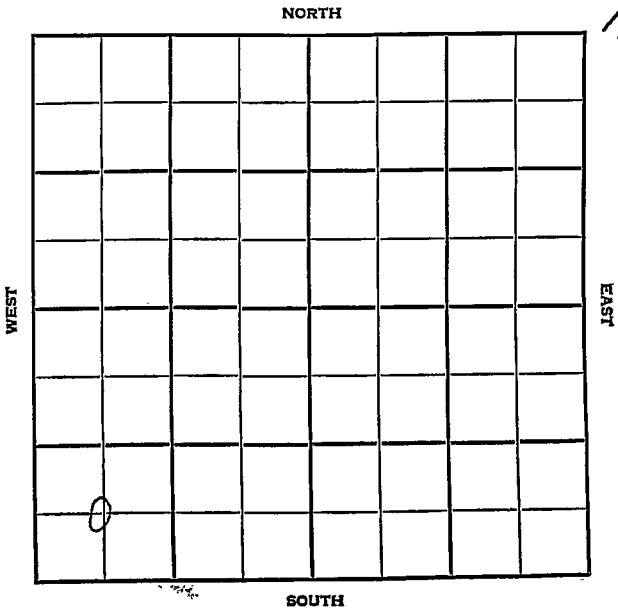

McPherson

KANSAS

SEC.

TWP.

R.

24

19

2W

WELL NO.

#1 Gratton

FARM

COMPANY

Geo. Hess

CONTRACTOR

Ritz-Canton

NORTH


400' Ft. from N. ^E Line
of old & abd. well

Ft. from S. Line

Ft. from E. Line

Ft. from W. Line

C SW SW

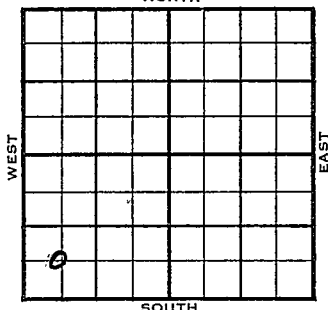

1955

ELEVATION

1556'

REPORT

8/3

Location

FIRST REPORT

9-7

8 5/8" @ 156

5 1/2" @ 3393

DD 3402

50 bwph, 1% oil PB perf. 2975

6 bwph perf. 2955, 2 bwph

Temp. abd.

Tops: M. 2919

V. 3390

T.D. 3394'

ABANDONED

County Mepherson Elev. _____
 Sec. 24 Twp. 19 Rge. 2W
 Company Geo. Hess
 Farm Name Gratton No. 1

TOPS	DEPTH	LOG	DATUM	Loc. in Sec.
Anb.				C SW SW
Ip.				
H.				400' NE of
Tr.				old abd. well
Dg.				
BL.				
L.				Geol.
K.C.				Contr.
B.K.C.				
Ce.				
C.				
M.				Pool
M.				Ritz-Canton
K.				
Mz.				
Ma.				
V.				
S.				
S.				
A.				
R.				
Pe.				
G.				
T.D.				

FIRST REPORT

AUG 3 '50

Date Comm.

Location

County McPherson Elev. 1556
 Sec. 21 Twp. 19 Rge. 2W
 Company Geo. Hess
 Farm Name Gratton No. 1

TOPS	DEPTH	LOG	DATUM	Loc. in Sec.
Anh.				C SW SW
TP.				
H.				
Tr.				
Dg.				
BL.				
L.				Geol.
K.C.				Contr.
B.K.C.				
Ce.				
C.				
M.	2919		1363	Pool
M.				
K.				
Mz.				
Ma.				
V.	3390		1834	
S.				
S.				
A				
R.				
PE.				
G.				
T.D.	3394			

ABANDONED

Date Comm. 7-28-55 SEP 7 1955

8 5/8" @ 156 5 1/2" @ 3393 DD 3402

50 bwph 1% oil PB perf. 2975

6 bwph perf. 2955 2 bwph

Temp. abd.