


Form 51-5M-2-29-34703

Map No. **KANSAS** Sec. **24** Twp. **19** R. **2W**

Well No. **L- Miller** Farm
Lario & Shell Company

NORTH

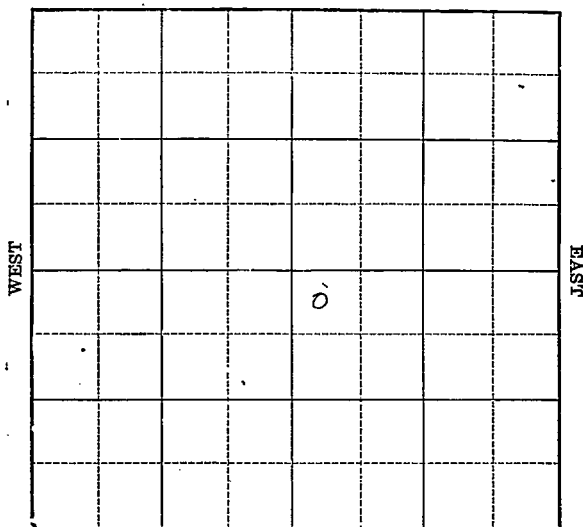

SOUTH

OWADD

Location _____

Drilling Remarks _____

Rig Up _____

Drilling Remarks _____

RECORD

Cased _____ in. _____ ft.

Sand _____

Gas _____

Oil _____

Total Depth _____

PRODUCTION

1st 24 hrs. Nat. _____

1st 24 hrs. after shot _____

Gas _____ cu. ft. _____

Dry Hole _____

Abandoned _____

Map No. KANSAS Sec. 24 Twp. 19 R. 2^w
Well No. 2- Miller Farm
Gario & Shell Company


330 Ft. from N. Line

_____ Ft. from S. Line

_____ Ft. from E. Line

330 Ft. from W. Line

1931 **OWDD**

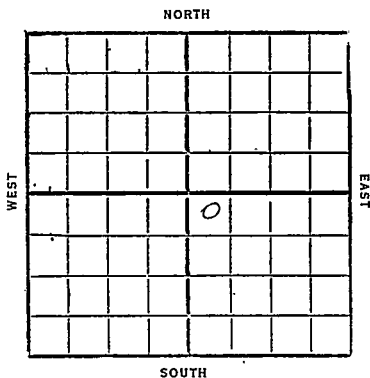

Date	REPORT
9/16	Loc
9/23	Bldg reg
9/30	
10/17	Spdg
10/14	Drlg 975'
10/21	" 1765'
10/28	10"-2232
11/4	Drlg 2360'
11/10	8"-2529
11/18	Drlg 2870'
12/2	6"-2906
12/9	Top Chat 2908
12/16	T.D. 3077 21/2 6"
12/22	Viola 3382-95
	2500' oil in hole
12/24	T.D. 3395' Fsg 5"
12/28	—
12/29	—
12/30	—
12/31	T.D. 3395
	Cg out & swabbing
	(over)

12/30- T.D. 3413' Viola
Kill shoot

1932

1/6- T.D. 3413' Viola
shot 15 qt 3408-13
swab (est) 15 bbl an hr

1/13- T.D. 3413'
Prep to pump.

1/20

1/27- Viola 3382-3413
T.D. 3413
shot 15 qt 3408-13
Potential prod
1029 bbl oil
Comp.

1933 O W D D

10/11 Dig. deeper

10/18 —

10/25 will not Deepen

COMPLETED

1934

O W D D

10/17 Rign

10/25 — 11/1 —

11/8 C.O. 3407

11/15 fsg 3407

11/22 —

11/28 C.O. 3300

12/6 3320 C.O.

12/13 fsg tools

12/21 — 12/27 — 1/3/35 —

1/9/35 T.D. 3320

J & F

ABANDONED

McPherson

Map No. **KANSAS** Sec. 24 Twp. 19 R. 2 ^W
 Well No. 43 2 Miller
Lewis & Sheep Company

Contractor

FIRST REPORTS

230 Ft. from N. Line

Ft. from S. Line

Ft. from E. Line

330 Ft. from W. Line

SECTION PLAT

		0	

Location ✓

Rig up

Drilling and Remarks:

RECORD

Cased in., ft.Sand Gas Oil Total Depth

PRODUCTION

1st 24 hrs. Nat. 1st 24 hrs. after shot Gas Cu. Ft.Dry Hole Abandoned

Date

SEP 1 6 1931 192 CHAS. L. SHERWOOD

Scout

W. J. C. J.

Returned	
Cards	
Tracing	<i>OK</i>
France Map	
Scarborough Map	
Moody Map	
Scarborough Plat Book	
Moody Plat Book	

McPherson

43 KANSAS

Map No. _____ Sec. 24 Twp. 19 R. 2

Well No. 2 Miller

Laris & Shell

Company

Contractor

COMPLETED

330 Ft. from N. Line

_____ Ft. from S. Line

_____ Ft. from E. Line

330 Ft. from W. Line

SECTION PLAT

		0	

Location _____

Rig up _____

Drilling and Remarks:

Shot 15/3408-13

Potential Prod.
1029 Bbls.

RECORD

Cased _____ in _____ ft.

Sand Molar 3382-3413

Gas _____

Oil _____

Total Depth 3413

PRODUCTION

1st 24 hrs. Nat. _____

1st 24 hrs. after shot _____

Gas _____ Cu. Ft.

Dry Hole _____

Abandoned _____

Date
JAN 27 1932

CHAS. L. CHERWOOD

19

Scout

Returned _____
Cards _____
Tracing *CPH* _____
France Map *X* _____
Scarborough Map *X* _____
Moody Map *X* _____
Scarborough Flat Book _____
Moody Flat Book _____

Map No. 43 Sec. 24 Twp. 19 R. 2W

Well No. 2-Miller

Lario & Shell Company

Contractor

FIRST REPORTS

330 Ft. from N. Line

..... Ft. from S. Line

..... Ft. from E. Line

330 Ft. from W. Line

SECTION PLAT

		0	

Location.....

Rig up.....

Drilling and Remarks:

OTD 3407

C, O,

RECORD

Cased.....in.,ft.

Sand.....

Gas.....

Oil.....

Total Depth.....

PRODUCTION

1st 24 hrs. Natl.....

1st 24 hrs. after shot.....

Gas.....Cu. Ft.

Dry Hole.....

Abandoned.....

Date

10-11-33 192

O. Manschick Scout

W. H. Hall
W. H. Hall

Returned	
Cards	<i>[initials]</i>
Tracing	<i>[initials]</i>
France Map	<i>[initials]</i>
Scarborough Map	<i>[initials]</i>
Moody Map	<i>[initials]</i>
Scarborough Plat Book	
Moody Plat Book	

Form 26-1M Rev. 9-29
 J. J. Pearson

Map No. 43 Sec. 24 Twp. 19 R. 2W

Well No. 2-Miller

Parrish & Shell Company

Contractor

SECTION PLAT

330 Ft. from N. Line

..... Ft. from S. Line

..... Ft. from E. Line

330 Ft. from W. Line

		0	

COMPLETED

Location.....

Rig up.....

Drilling and Remarks:

Reported as cased

Did not deepen

RECORD

Cased..... in., ft.

Sand.....

Gas.....

Oil.....

Total Depth 3407

PRODUCTION

1st 24 hrs. Nat.....

1st 24 hrs. after shot.....

Gas..... Cu. Ft.

Dry Hole.....

Abandoned.....

Date

10-25-33 192

O. Mennelbach Scout

Returned

Cards

Tracing

France Map

Scarborough Map

Moody Map

Scarborough Plat Book

Moody Plat Book

KANSAS

Map No. 43 Sec. 24 Twp. 19 R. 2W

Well No. 2. Miller

Lario Oil & Gas Company

Contractor

FIRST REPORT

SECTION PLAT

330 Ft. from N. Line

_____ Ft. from S. Line

_____ Ft. from E. Line

330 Ft. from W. Line

QWDN

		o	

Location _____

Rig up _____

Drilling and Remarks:

OTN 3407

Rgn

RECORD

Cased _____ in., _____ ft.

Sand _____

Gas _____

Oil _____

Total Depth _____

PRODUCTION

1st 24 hrs. Nat. _____

1st 24 hrs. after shot _____

Gas _____ Cu. Ft.

Dry Hole _____

Abandoned _____

Date

10-17-37 19

Scout

Returned

Cards

Tracing

France Map

Scarborough Map

Moody Map

Scarborough Plat Book

Moody Plat Book

KANSAS

Map No. 43 Sec. 24 Twp. 19 R. 2WWell No. 2-MillerLario Oil Gas Company

Contractor

ABANDONED

SECTION PLAT

330 Ft. from N. Line

.....Ft. from S. Line

.....Ft. from E. Line

330 Ft. from W. Line

OWN

		0	

Location.....

Rig up.....

Drilling and Remarks:

10 x 77

RECORD

Cased.....in.,ft.

Sand.....

Gas.....

Oil.....

Total Depth 3320

PRODUCTION

1st 24 hrs. Nat.....

1st 24 hrs. after shot.....

Gas.....Cu. Ft.

Dry Hole.....

Abandoned.....

Date

1-9-35 192..... DEWAT. MANNISCHKE Scout

Returned

Cards

Tracing

France Map

Scarborough Map

Moody Map

St. John's Map

St. John's Book