


Map No. KANSAS Sec. 24 Twp. 19 R. 2^w

Well No. 2 - Haley Farm
Madison & Shell Company

_____ Ft. from N. Line
330 Ft. from S. Line
_____ Ft. from E. Line
330 Ft. from W. Line
1931

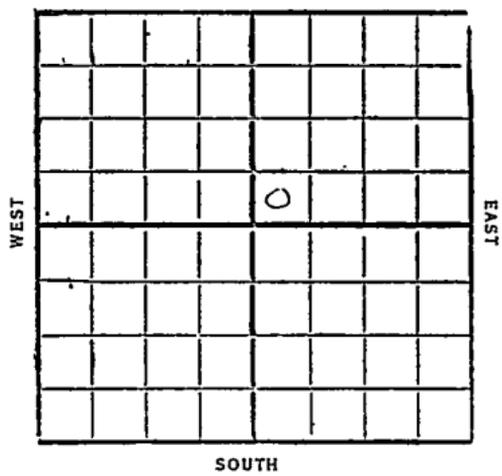

Date	REPORT
9/30	Log
10/7	Run up
10/14	
10/21	Drilg 295'
10/28	" of 1040'
11/4	Set 12" - 1395'
11/10	Drilg 1638'
11/18	" of 2205'
11/24	SD. 2330'
12/3	Drilg 2485'
12/9	" of 2635'
12/16	" 2921'
12/22	TD. 2970' Log
12/30	
1932	
1/6	—
1/13	—
1/20	—
1/27	—
2/3	—
2/10	Drilg up bailer 3036
2/17	—

2/26- Drg 3145'
3/2- Top Viola 3397
First oil 3400
T.D. 3414
shot 10 qt 3403-11
2500' oil in hole
Png tubing
3/9- T.D. 3414 No test
3/16- T.D. 3414
swab 70 bbl per hr
for 7 hours
3/22 —
3/30- T.D. 3414' No test
4/6- Viola 3397-3414
T.D. 3414
shot 10 qt 3403-11
Potential prod
1240 bbl oil
Comp.

43

McPherson

Map No. KANSAS Sec. 24 Twp. 19 R. 2 ^W

Well No. 2 Hale

Madison & Shell Company

Contractor

FIRST REPORTS

SECTION PLAT

.....Ft. from N. Line

330 Ft. from S. Line

.....Ft. from E. Line

330 Ft. from W. Line

		0	

Location.....

Rig up Log

Drilling and Remarks:

RECORD

Cased.....in.,ft.

Sand.....

Gas.....

Oil.....

Total Depth.....

PRODUCTION

1st 24 hrs. Nat.....

1st 24 hrs. after shot.....

Gas.....Cu. Ft.

Dry Hole.....

Abandoned.....

Date

SEP 3 0 1931

CHAS. L. SHERWOOD

[Handwritten signature]

Returned	<i>[Handwritten initials]</i>
Cards	<i>[Handwritten initials]</i>
Tracing	<i>MS</i>
France Map	<i>X</i>
Scarborough Map	<i>[Handwritten mark]</i>
Moody Map	<i>X</i>
Scarborough Plat Book	
Moody Plat Book	

McPherson

43 KANSAS

Map No. _____ Sec. *24* Twp. *19* R. *2*^W

Well No. *2* *Hale*

Madison & Sheel Company

Contractor

COMPLETED

SECTION PLAT

_____ Ft. from N. Line

330 Ft. from S. Line

_____ Ft. from E. Line

330 Ft. from W. Line

		0	

Location _____

Rig up _____

Drilling and Remarks:

Shot 10/3403-3411

*Potential Prod
1240 Bbls.*

RECORD

Cased _____ in., _____ ft.

Sand *Viola 3397-3414*

Gas _____

Oil _____

Total Depth *3414*

PRODUCTION

1st 24 hrs. Nat. _____

1st 24 hrs. after shot _____

Gas _____ Cu. Ft.

Dry Hole _____

Abandoned _____

Date

APR 6 1932

CHAS. L. SHERWOOD

Scout

[Handwritten scribbles and lines]

Returned	<i>[Signature]</i>
Cards	<i>[Signature]</i>
Tracing	<i>[Signature]</i>
France Map	<i>[Signature]</i>
Scarborough Map	<i>[Signature]</i>
Moody Map	<i>[Signature]</i>
Scarborough Plat Book	
Moody Plat Book	