


Mc Pherson

Form 51-5M-11-31-Palace

Map No. **KANSAS** Sec. 24 Twp. 19 R. 2W

Well No. 5 Boals Farm
Lario Oil & Gas Company

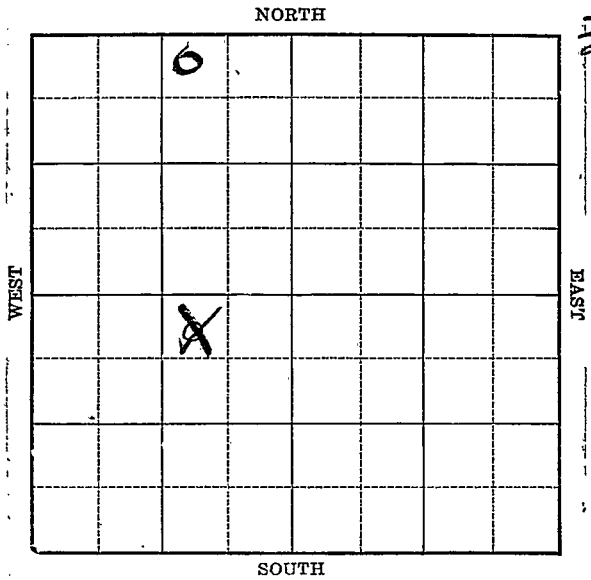

Location _____
Drilling Remarks _____

Rig Up _____
Drilling Remarks _____

RECORD

Cased _____ in. _____ ft.
Sand _____
Gas _____
Oil _____
Total Depth _____

PRODUCTION

1st 24 hrs. Nat. _____
1st 24 hrs. after shot _____
Gas _____ cu. ft.
Dry Hole _____
Abandoned _____

McPherson

Map No. KANSAS Sec. 24 Twp 19 R. 2^W

Well No. 5 Boals Farm


Lario O & G. Company

330' Ft. from N. Line

_____ Ft. from S. Line

940' Ft. from E. Line

_____ Ft. from W. Line

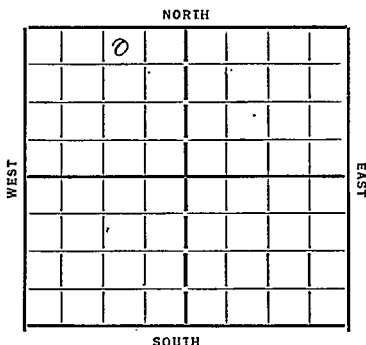

Date 1/24

REPORT

1/3	15"-132'
1/11	Drilg 2273
1/17	Top Chat 2927
	Drilg 3070
1/24	T.D. 3397 B.U.S.T.
1/31	Viola 3396 TD BL 3132 Bailing
2/7	TD 3405 1000 gal acid
2/14	—
2/21	Viola 3396 TD 3397 1000 Gal acid 533 Bble.

COMPLETED

Map No. 43 Sec. 24 Twp. 19 R. 2W

Well No. 5-Boals

Lario O & G Company

Contractor

FIRST REPORTS


SECTION PLAT

330 Ft. from N. Line

_____ Ft. from S. Line

990 Ft. from E. Line

_____ Ft. from W. Line

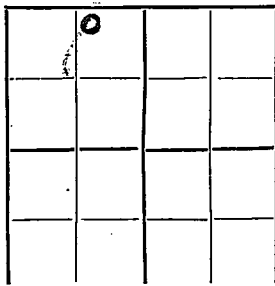

Location _____

Rig up _____

Drilling and Remarks:

15" 132'

RECORD

Cased _____ in., _____ ft.

Sand _____

Gas _____

Oil _____

Total Depth _____

PRODUCTION

1st 24 hrs. Nat. _____

1st 24 hrs. after shot _____

Gas _____ Cu. Ft.

Dry Hole _____

Abandoned _____

Date

1-3-34 192 O. Mannschreck Scout

Map No. 43 Sec. 24 Twp. 19 R. 24

Well No. 5-Boals

Lario Company

Contractor

COMPLETED

SECTION PLAT

	0		

330 Ft. from N. Line

_____ Ft. from S. Line

990 Ft. from E. Line

_____ Ft. from W. Line

RECORD

Location _____

Cased _____ in. _____ ft.

Rig up _____

Sand Viola 3396

Drilling and Remarks:

Gas _____

1000 gal acid

Oil _____

Total Depth 3397

PRODUCTION

533 bbls

1st 24 hrs. Nat. _____

1st 24 hrs. after shot _____

Gas _____ Cu. Ft.

Dry Hole _____

Abandoned _____

Date

2-21-34 192 O. Mammuch Scout