


SECTION 24 TOWNSHIP 19 RANGE 11 W

WELL NO.: #1 Great Bend

COMPANY Skelly Oil

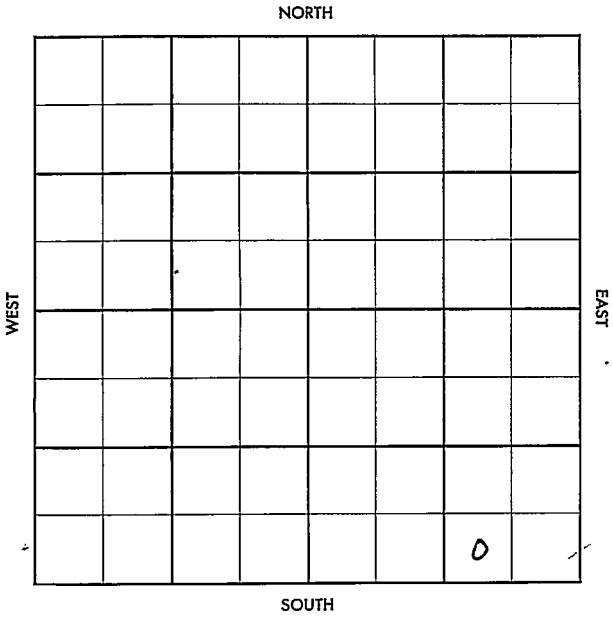

Barton

KANSAS

SEC.	24	TWP.	19	R.	14W
------	----	------	----	----	-----

WELL NO. #1 Great Bend FARM

COMPANY Skelly Oil

CONTRACTOR Wentworth

Semi-Wildcat


_____ Ft. from N. Line

_____ Ft. from S. Line

_____ Ft. from E. Line

_____ Ft. from W. Line

SW SE SE

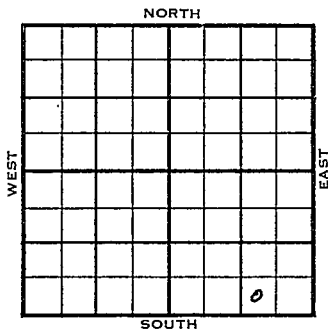

1955	ELEVATION	REPORT
	1864'	

11/2	Comm 10-30-55 8" @ 785 Anh 770 WOC	
------	---	--

11-16	DST 3195-3220 op 1 hr. rec. 15' ocm 12/20" DST 3248-75 open 1 hr. rec. 35' wcm 895# DST 3315-45 op 1 hr. rec. 8' mud, 22# DST 3487-96 op 1 hr. rec. 100' hocm 180# DST 3496-3506 op 1 hr. rec. 155' sw, 970# D & A T.D. 3506' Tops: H. 3092' Tr. 3106' Dg. 3124' Bl. 3191 L. 3202 C. 3418 A 3492	ABANDONED
-------	---	-----------

County Barton Elev. _____
 Sec. 24 Twp. 19 Rge. 11W
 Company Skelly Oil
 Farm Name Great Bend No. 1

TOPS	DEPTH	LOG	DATUM
Anh.	<u>770</u>		
Tr.			
H.			
Tr.			
Dg.			
Bl.			
L.			
K.C.			
B.K.C.			
Ce.			
C.			
M.			
M.			
K.			
Mz.			
Ma.			
V.			
S.			
S.			
A.			
R.			
Pe.			
G.			
T.D.			

Loc. in Sec. SW SE SE
 Geol. _____
 Contr. Wentworth
 Pool Semi Wildcat

FIRST REPORT
 NOV 2 1955
 0

Date Comm. 10-30-55
8hr @ 785 WCC

Handwritten signature/initials

Co. _____
 Use _____
 No. _____
 Sec. _____
 T. _____
 R. _____

County Barton Elev. 1864
 Sec. 21 Twp. 19 Rge. 14W
 Company Skelly Oil
 Farm Name Great Bend No. 1

TOPS	DEPTH	LOG	DATUM	Loc. in Sec.
Anh.	<u>770</u>			SW SE SE
Tr.				
H.	<u>3092</u>		<u>1238</u>	
Tr.	<u>3106</u>		<u>1242</u>	
Dg.	<u>3124</u>		<u>1260</u>	
BL.	<u>3191</u>		<u>1327</u>	
L.	<u>3202</u>		<u>1338</u>	
K.C.				Geol.
B.K.C.				Contr.
Ce.				
C.	<u>.3418</u>		<u>1554</u>	Wentworth
M.				Pool
M.				Semi Wildcat
K.				
Mz.				
Ma.				
V.				
S.				
S.				
A.	<u>.2492</u>		<u>1628</u>	
R.				
PE.				
G.				
T.D.	<u>.3506</u>			

ABANDONED

Date Comm. 10-30-55 NOV 16 1955

8" @ 785 DST 3195-3220 open 1 hr.

rec. 15' ocm 12/20" DST 3248-75

open 1 hr. rec. 35' wcm 895#

EX (PT) DST 3315-45 open 1 hr. rec. 8' mud

22# DST 3487-96 open 1 hr. rec.

100' hocm 180# DST 3496-3506

open 1 hr. rec. 155' sw 970#

D & A