


Section 24 Township 19 Range 14 WWell No. # 1 GibsonCompany Geo. Hannum Drlg.

NORTH

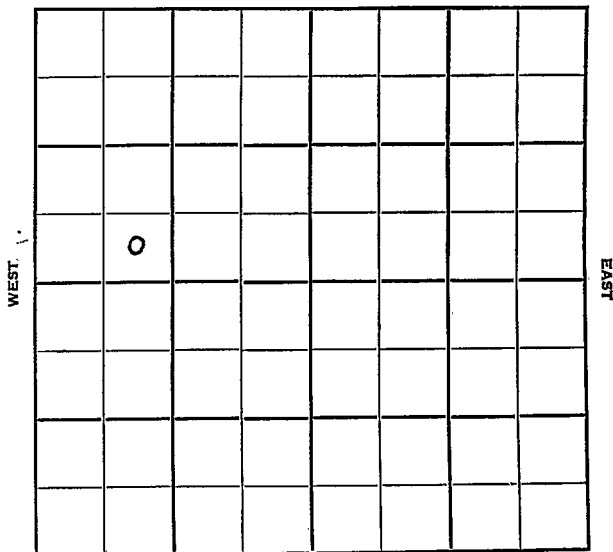

SOUTH

KANSAS

Barton
19

Sec. 24 Twp. 19 R. 14W

Well No. #1 Gibson Farm

Geo. Hannum Drlg. Company

Hannum Drlg. - Contr. Contractor


Ft. from N. Line

330' Ft. from S. Line

Ft. from E. Line

990' Ft. from W. Line

SE SW NW

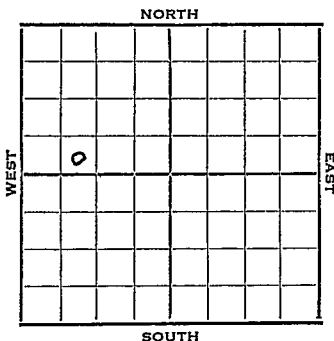

1951

Elev. 1866' REPORT

12/12


Spud 12-10-51
Spdg.

1952

1/2 Spud 12-10-51
D & A TD 3485' 8" @ 800'
Anhy 783' Heeb 3096' Br. lime 3194'
Lans. 3206'
DST 3208-78' open $\frac{1}{2}$ hr. rec 38' mud
DST 3336-70' open 1 hr, rec 95' mud
Cong. 3421'
DST 3469-85' open $\frac{1}{2}$ hr. rec 10' mud
TD 3485' D & A

ABANDONED

County Barton State KANSAS
 Sec. 24 (Blk.) 19 (Sur.) 14W Map No.
 Operator Geo. Hannum Drig.
 Well No. 1 Farm Gibson
 Elev. _____ Location SE SW NW

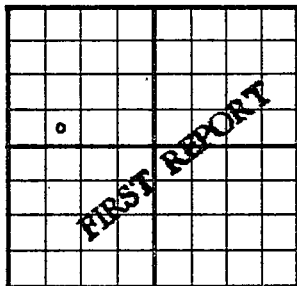


330 Ft. From S Line NW
990 Ft. From W Line Quarter
 1st. Report DEC 1 2 1951
 Completion _____
 Remarks Hannum Drig. - Contr.
 Spudding Date 12-10-51

Drig. Data _____

Spdg. _____

J. E. TYRA

County Barton State Kansas
 Sec. 24 (Blk.
Twp.) 19 (Sur.
Rge.) 14W Map No.
 Operator Geo. Hannum D. lg.
 Well No. 1 Farm Gibson
 Elev. 1866 Location SE SW NW

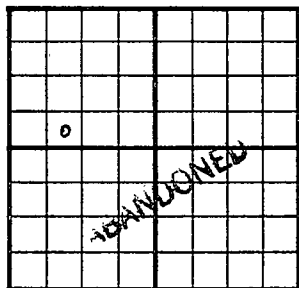

330 Ft. From S Line NW
990 Ft. From W Line Quarter

1st. Report

Completion JAN 2 1952

Remarks

Hannum D. lg. - Contr.

Spudding Date 12-10-51

Drlg. Data D & A TD 3485

8" @ 800 Anhy 783 Heeb. 3096

Br. lime 3194 Lans. 3206 DST 3208-78

open $\frac{1}{2}$ hr. Rec. 38' mud DST 3336-70

open 1 hr. Rec. 95' mud Cong. 3421

DST 3469-85 open $\frac{3}{4}$ hr. Rec. 10' mud

TD 3485 D & A

J. E. TYRA