


Section 24 Township 19 Range 13WWell No. 1 - Edna ButtonCompany Duke & Wood

NORTH

WEST

EAST

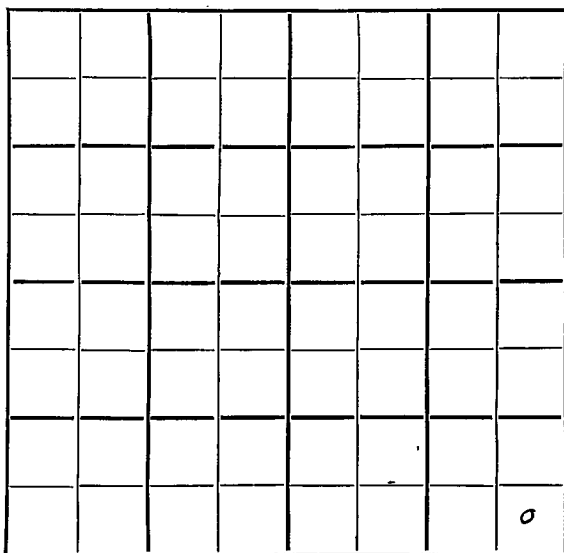

SOUTH

KANSAS ✓

Barton

Sec. 24 Twp. 19 R. 13WWell No. 1 Edna Button FarmDuke & Wood


Company

Duke & Wood - Contr.

Contractor

Ft. Zarah Pool Ft. from N. Line330 Ft. from S. Line330 Ft. from E. Line Ft. from W. Line

SE SE SE

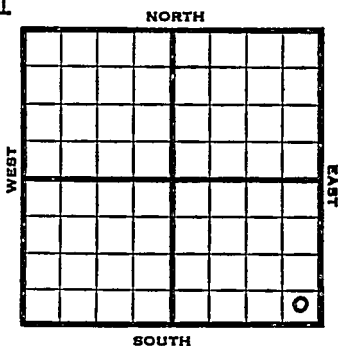

1953

Elev. 1829' REPORT

4/1

Spud 3-27-53

8" @ 163

Drlg 1761

4/9

Heeb 3041' Br li 3155' Lans 3173'

DST 3250-3313, 1 hr, 83' M 1012#

15".

Drlg. 3434'

4/16

D & A

4/23

"

4/29

Spud 3-27-53

D & A

TD 3441'

8" @ 163'

Heeb 3041, Br. Lime 3155, Lans 3173,

DST 3250-3313 opn 1 hr, rec 83' mud,

1012#

Cong. 3409, Arb 3432


TD 3441'

D & A

ABANDONED

J. G. McGEHEE

County Barton State Kansas
 Sec. 24 (Blk.) 19 (Sur.) 13W Map No.
 Operator Duke & Wood
 Well No. 1 Farm Edna Button
 Elev. 1829 Location SE SE SE

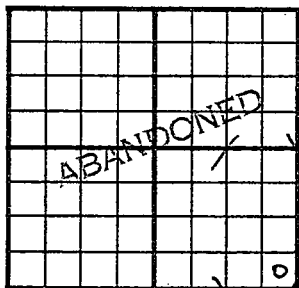

330 Ft. From S Line SE
330 Ft. From E Line Quarter

1st. Report

Completion APR 29 1953

Remarks Ft. Zarah Pool
Duke & Wood - Contr.

Spudding Date 3-27-53

Drig. Data D & A TD 3441

8" @ 163 Heeb. 3041 Br. lime 3155

Lans. 3173 DST 3250-3313 open 1 hr.

Rec. 83' mud 1012# Cong. 3409

Arb. 3432 TD 3441

D & A

J. G. McGEHEE