
FORM 51 25M 3-49 PETROL Barton KANSAS

Section 24 Township 19 Range 13W

Well No. #1 Cook

Company Flourney & Hastin

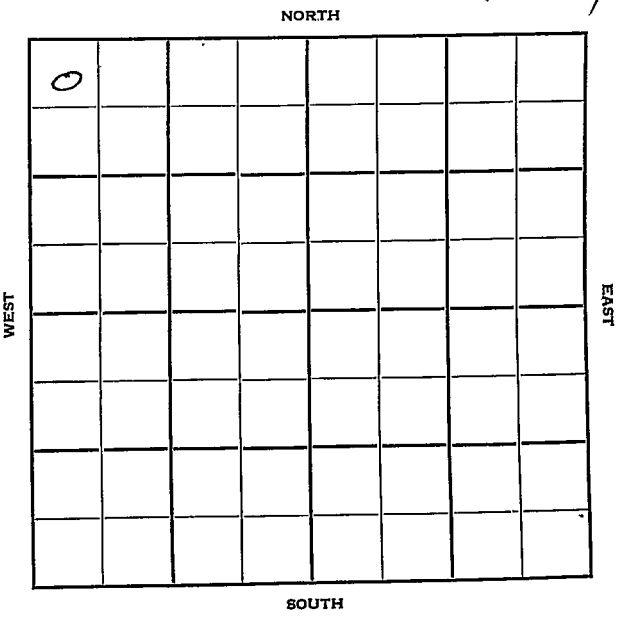

FORM 252-B

Barton

Sec. 24 Twp. 19 KANSAS R. 13W

Well No. #1 Cook Farm

Flourney & Hastin Company

Contractor


330 Ft. from N. Line

Ft. from S. Line

Ft. from E. Line

330 Ft. from W. Line

NW¼ NW NW NW

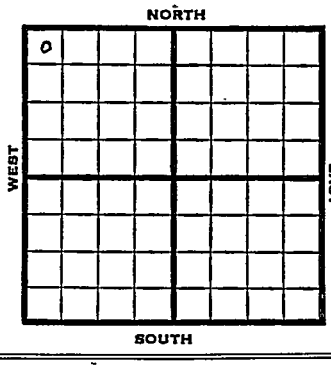

1952	Elev. 1837' REPORT
11/5	MIR
11/12	8" @ 154 Drlg. 2940'
11/20	Heeb 3039' Br li 3152' Lans. 3168' Arb. 3409' DST 3170-3210, 1/2 hr, 6' M DST 3221-41, 1 hr, 250' OCM 120# 15" DST 3409-17, 1 hr, 8' M 5' oil 1500# RTD 3417' 5" @ 3411
11/27	NR
12/4	CO 3417, 1000A, DD 3435 1000A, DD 3438 TD HFW 5/3412-16, PB 3400, 10/3367-79 PB 3315, 7/3302-06, 13225-32
12/11	1000A S/1½ BOPH 2000A S/3 BOPH P/2 BOPH 4 Hrs. Shut in for tanks
12/18	NR
12/25	NR
1/1	NR
1/8	P/2 BOPH
1/22	"
1/29	NR
2/5	"

OVER

#1 Cook

1953

2/12 NR

2/19 "

2/25 Spud 11-5-52 D & A TD 3438
8" @ 154 Heeb 3039 Br. lime 3152
Lans. 3168 Arb. 3409
DST 3170-3210 open ½ hr. rec 6' mud
DST 3221-41 open 1 hr. rec 250' OCM
120#
DST 3409-17 open 1 hr. rec 8' mud
5' oil 1500# TD 3417 5" @ 3411
CO to 3417 1000 A DD 3435 1000 A
DD 3438 HFW 5/3412-16 PB 3400
10/3367-79 PB 3315 7/3302-06
10/3222-30 SO & W 1000 A
S/1¼ BOPH 2000 A S/3 BOPH P/2
BOPH 4 hr. P/12 BOPD 1½ BW
P/10 BOPD 2 BW Oil dec. to 2 BOPD
wtr. inc.
D & A

ABANDONED

FORM 275 FOR SALE BY KANSAS BLUE PRINT CO.


County Barton State Kansas

Sec. 24 (Blk. Twp.) 19 (Sur. Rge.) 13W Map No.

Operator Flourney & Hastin

Well No. 1 Farm Cook

Elev. Location NW NW NW

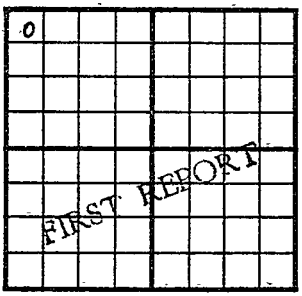

330 Ft. From N Line NW

330 Ft. From W Line Quarter

1st. Report NOV 5 1952

Completion

Remarks

Spudding Date

Drlg. Data

M I R

J. G. McGEHEE

FORM 275 FOR SALE BY KANSAS BLUE PRINT CO.


County Barton State Kansas

Sec. 24 (Blk. Twp.) 19 (Sur. Rge.) 13W Map No.

Operator Flourney & Hastin

Well No. 1 Farm Cook

Elev. 1837 Location NW NW NW

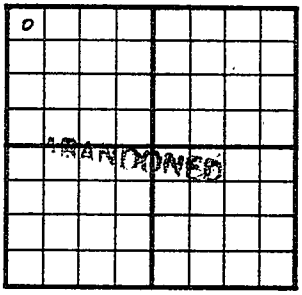

330 Ft. From N Line NW

330 Ft. From W Line Quarter

1st. Report

Completion FEB 25 1953

Remarks

Spudding Date 11-5-52

Drlg. Data D & A TD 3438

8" @ 154 Heeb. 3039 Br. lime 3152

Lans. 3168 Arb. 3409 DST 3170-3210

open ½ hr. Rec. 6' mud DST 3221-41

open 1 hr. Rec. 250' ocm 120#

DST 3409-17 open 1 hr. Rec. 8' mud

5' oil 1500# TD 3417 5" @ 3411

CO to 3417 1000 A DD 3435 1000 A

DD 3438 HFW 5/ 3412-16 PB 3400

10/ 3367-79 PB 3315 7/ 3302-06

10/ 3222-30 SO & W 1000 A S/ 1¼ boph

2000 A S/ 3 boph P/ 2 boph 4 hr.

P/ 12 bopd 1½ bw P/ 10 bopd 2 bw

Oil dec. to 2 bopd wtr. inc.

D & A

G McGEHEE