


KANSAS

Section 24 Township 19 Range 16W

Well No. #2 Tammen

Company Solar Oil

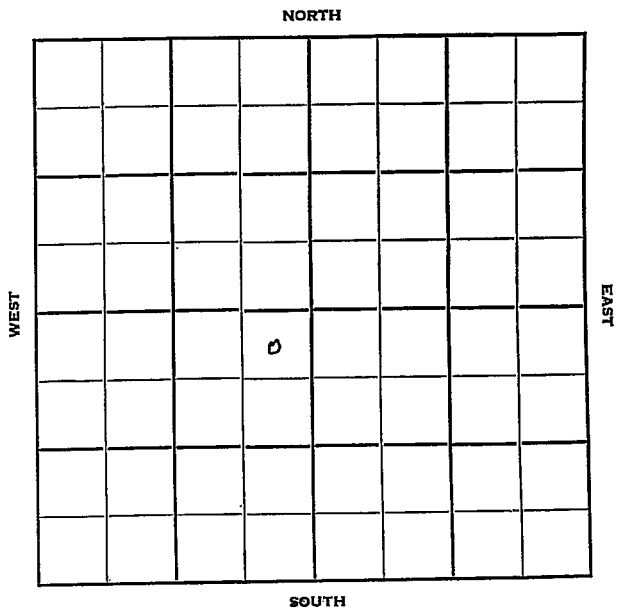

Rush

KANSAS

Sec. 24 Twp. 19 R. 16W

Well No. #2 Tammen Farm

Solar Oil Company

Braden Drlg. - Contr. Contractor

Ryan Pool


330' Ft. from N. Line

_____ Ft. from S. Line

330' Ft. from E. Line

_____ Ft. from W. Line

NE NE SW

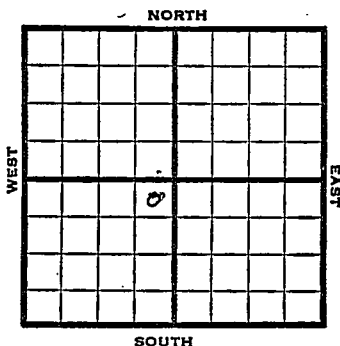

1951

Elev. 1979' REPORT

11/21

Spud 11-15-51
Anhy 1040
8" @ 1050
Drlg. 1055'

12/5

Spud 11-15-51
D & A TD 3745'
Anhy 1040' 8" @ 1050
Heeb 3278' Doug 3305' Br. lime 3348
Lans. 3365' B KC 3606' Cong. 3641'
Arb. 3666'
DST 3669-76 open 1 hr. rec 25' GCM
TD 3745' D & A

ABANDONED

