

G.W.W.O.


FORM 51 10M 7-48 PETROL

KANSAS Barton

Section 24 Township 19 Range 15-W

Well No. #1 Russell

Company ~~E/Reco~~
~~Amerada~~
Wildcat

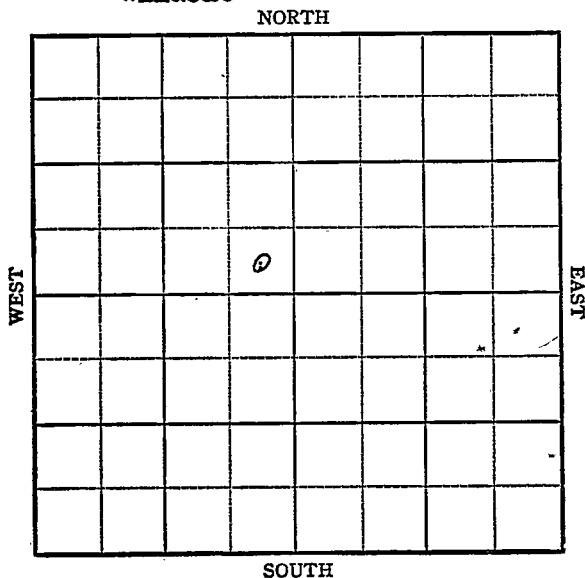

O.W.W.O.


KANSAS

Barton ✓

Sec. 24 Twp. 19 R. 15-W ✓Well No. #1 Russell Farm~~E/reco~~
~~Amerada~~

Wildcat

Sterling Drlg. - Contr. Company

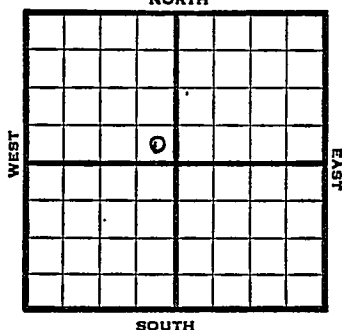 Ft. from N. Line330 Ft. from S. Line330 Ft. from E. Line Ft. from W. Line

SESE NW

1948

ELV. 1904'

REPORT

10/13

RUR

10/19

8" @ 824'

Drlg 2435'

10/26

Drlg 3514'

11/3

Arbuckle 3542'

Reagan 3641'

Granite 3651'

TD 3659'

11/10

TD 3659'

Arb. 3542'

Reagan 3641'

Granite 3651'

Aband.

ABANDONED

O.W.W.O.

1953

4/22

KC 3228' Cong. 3496' Arb. 3542'

Regan 3641' Gr. 3651'

OTD 3659' To CO.

4/30

CO 3659' 5" @ 3659'

5/6

D&A

TD 3660

KC 3228, Cong. 3496, Arb. 3542, Regan 3641, Gr 3651,

OTD 3659

CO to 3659,

5" @ 3659

CO to 3660, 24/3545-53, 16/3554-60

60 gw, 500A, 20 gwph, FU 100' wtr.

18hr., 3000A, PB 3419, 24/3384-92,

500A, 1 1/2 bwph 6 hrs.

D&A

ABANDONED

Map No. _____ Sec. 24 Twp. 19 R. 15W
~~75W~~Well No. 1 RussellAmerada


Company

FIRST REPORT

Contractor

SE NW

SECTION PLAT

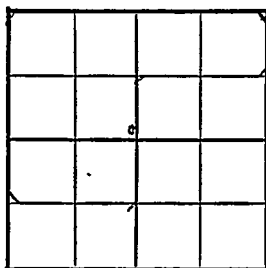

____ Ft. from N. Line

330 Ft. from S. Line330 Ft. from E. Line

____ Ft. from W. Line

Barton County

Location _____

Rig up _____

Drilling and Remarks:

R U R

RECORD

Cased _____ in., _____ ft.

Sand _____

Gas _____

Oil _____

Total Depth _____

PRODUCTION

1st 24 hrs. Nat. _____

1st 24 hrs. after shot _____

Gas _____ Cu. Ft.

Dry Hole _____

Abandoned _____

Date

OCT 13 1948

19

S. J. LEWIS

Scout

Map No. 82 Sec. 24 Twp. 19 R. 15W

Well No. 1 Russell

Amerada

Company

ABANDONED

Contractor

SE NW


E. 1904
SECTION PLAT

 Ft. from N. Line

330 Ft. from S. Line

330 Ft. from E. Line

 Ft. from W. Line

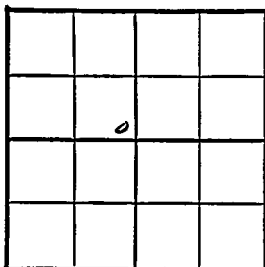

Barton County

Location

Rig up

Drilling and Remarks:

Ce 8542
Reagan 3641
Granite 3657

RECORD

Cased in., ft.

Sand

Gas

Oil

Total Depth 2659

PRODUCTION

1st 24 hrs. Nat.

1st 24 hrs. after shot

Gas Cu. Ft.

Dry Hole

Abandoned

Date

NOV 10 1948

19


S. J. LEWIS

Scout

J. G. McGEHEE

OWWO

County Barton State Kansas
 Sec. 24 (Blk. 19) (Sur. 15W) Map No. 15W
 Operator Elreco (was Amerada)
 Well No. 1 Farm Russell
 Elev. 1904 Location Russell

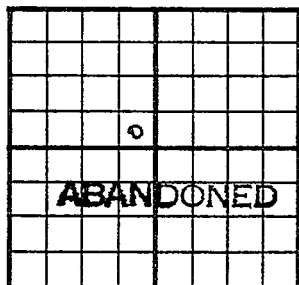

330 Ft. From S Line NW
 330 Ft. From E Line Quarter

1st. Report

Completion MAY 6 1953

OWWO**OWWO**

Sterling Drlg. - Contr.

Spudding Date

Drlg. Data D & A TD 3660

KC 3228 Cong. 3496 Arb. 3542

Regan 3641 Gr. 3651 OTD 3659

CO to 3659 5" @ 3659 CO to 3660

24/ 3545-53 16/ 3554-60 60 gw

500 A. 20 gwph FU 100' wtr. 18 hr.

3000 A PB 3419 24/ 3384-92 500 A

1½ bwph 6 hr.

D & A

J. G. McGEHEE