

KANSAS


Barton

FORM 51 5M 10-41 PETROL

Section 25 Township 19 Range 11-W

Well No. #3 Roth

Company J. H. Hershey

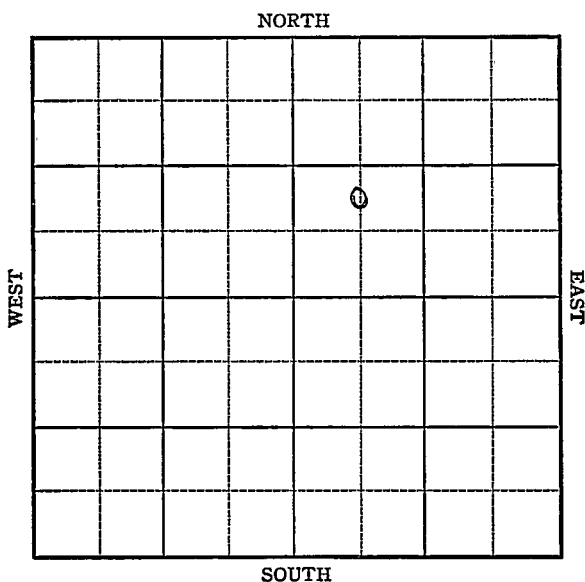

KANSAS

Barton

Sec. 25 Twp. 19 R. 11-W

Well No. #3 Roth Farm

J. H. Hershey Company

Silica

Ft. from N. Line


990

Ft. from S. Line

Ft. from E. Line

660

Ft. from W. Line

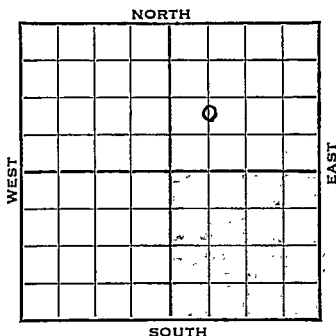

1943

REPORT

3/3

Location 2/24/43
8" Casing set 205'
Anhy 480'
Drlg. 1920'

3/10

3060' Fsg.

3/17

Drlg. 3108

3/24

Arb. 3302-07 T.D.

5" @ 3305'

3/31

RUST

4/7

"

4/14

T.D. 3327½'

Pump 18 bbls oil per hr.

4/21

6000 acid

Pump 79 Pot.

4/28

"

5/5

"

5/12

Arb. 3302

5" @ 3305'

T.D. 3327½'

6000 gal. acid

Pump 432' Pot.

Gravity 43.7

COMPLETED

X

KANSAS

Map No. 46 Sec. 25 Twp. 19 R. 11WWell No. 3 RothJ. H. Hershey

Company

FIRST REPORT

Contractor

C NL SW NE

SECTION PLAT

		o	

Ft. from N. Line

990

Ft. from S. Line

Ft. from E. Line

660

Ft. from W. Line

SILICA POOL

Location 2/24/43

Rig up

Drilling and Remarks:

8"-205'Anhy. 480'Drilg. 1920'

RECORD

Cased _____ in., _____ ft.

Sand _____

Gas _____

Oil _____

Total Depth _____

PRODUCTION

1st 24 hrs. Nat. _____

1st 24 hrs. after shot _____

Gas _____ Cu. Ft.

Dry Hole _____

Abandoned _____

Date

MAR 3 194319S. J. LEWIS Scout

Barton

KANSAS

Map No. 46 Sec. 25 Twp. 19 R. 11WWell No. 3 Roth

J. H. Hershey Company

COMPLETED Contractor


C NL SW NE

SECTION PLAT

_____ Ft. from N. Line

990 Ft. from S. Line

_____ Ft. from E. Line

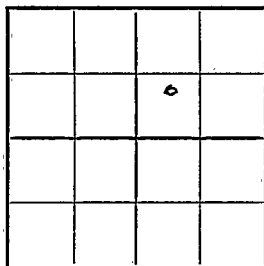660 Ft. from W. Line

SILICA POOL

Location _____

Rig up _____

Drilling and Remarks:


RECORD

Cased _____ in. _____ ft.

Sand _____

Gas _____

Oil _____

Total Depth 3327 1/2

PRODUCTION

1st 24 hrs. Nat. _____

1st 24 hrs. after shot _____

Gas _____ Cu. Ft.

Dry Hole _____

Abandoned _____

Date

MAY 1 2 1943

19

S. J. LEWIS Scout