


Section 25 Township 19 Range 11-W

Well Number 2-Isorn


Company Sinclair-Prairie

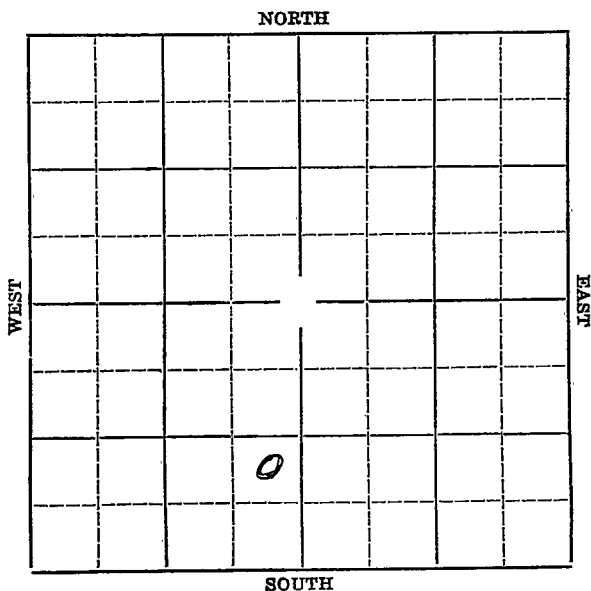

Map No. **KANSAS** Sec. **25** Twp. **19** R. **11W**

Well No. **#2 Isern** Farm _____
Sinclair-Prairie Company

_____ Ft. from N. Line
990' Ft. from S. Line
330' Ft. from E. Line
_____ Ft. from W. Line

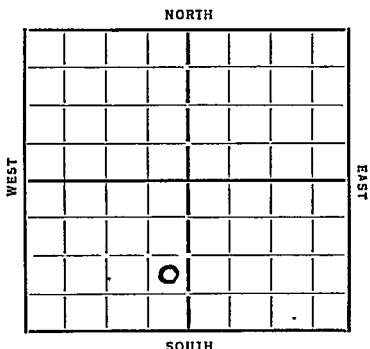

Elev. 1765

Date	REPORT
1936	
5/6	Rigging up.
5/14	165'-12". Drlg. 1750'.
5/21	Sil. 3292'. T.D. 3293' Set 6-5/8"- Rigging up standard tools.
5/28	--
6/4	T.D. 3326' Water. P.B. 3317'. 1000 Gallons acid. 69 bbls. 3000 acid. No test.
6/11	Pump 150 bbls oil. 5000 gallons acid.
6/17/36	Sil. 3292'.
	T.D. 3326'.
	P.B. 3317'.
	9000 gallons acid.
	Potential 256 bbls of oil.
	COMPLETED

Map No. 46 Sec. 25 Twp. 19 R. 11W

Well No. 2 Lucas

Sinclair-Prairie Company

Contractor

SECTION PLAT

..... Ft. from N. Line

990 Ft. from S. Line

330 Ft. from E. Line

..... Ft. from W. Line

FIRST REPORT

Location.....

Rig up.....

Drilling and Remarks:

Rigging up.

RECORD

Cased..... in., ft.

Sand.....

Gas.....

Oil.....

Total Depth.....

PRODUCTION

1st 24 hrs. Nat.....

1st 24 hrs. after shot.....

Gas..... Cu. Ft.

Dry Hole.....

Abandoned.....

Date

MAY 6 1936 192.....

S. J. LEWIS

Scout

KANSAS

Map No. 46 Sec. 25 Twp. 19 R. 11W

Well No. 2. Isaac

Sinclair-Pearce Company

Contractor

SECTION PLAT

		0	

_____ Ft. from N. Line

750 Ft. from S. Line

330 Ft. from E. Line

_____ Ft. from W. Line

COMPLETED

Location _____

Rig up _____

Drilling and Remarks:

Sil 3292

P.B. 3317

9000 acid

Prod 256 7/16

RECORD

Cased _____ in., _____ ft.

Sand _____

Gas _____

Oil _____

Total Depth 2326

PRODUCTION

1st 24 hrs. Nat. _____

1st 24 hrs. after shot _____

Gas _____ Cu. Ft.

Dry Hole _____

Abandoned _____

Date

JUN 17 1936

S. J. LEWIS

Scout