

KANSAS


Form 51-5M-4-36-Palace

Barton

Section 25 Township 19 Range 11-W

Well Number #5 Isern

Company Sinclair-Prairie

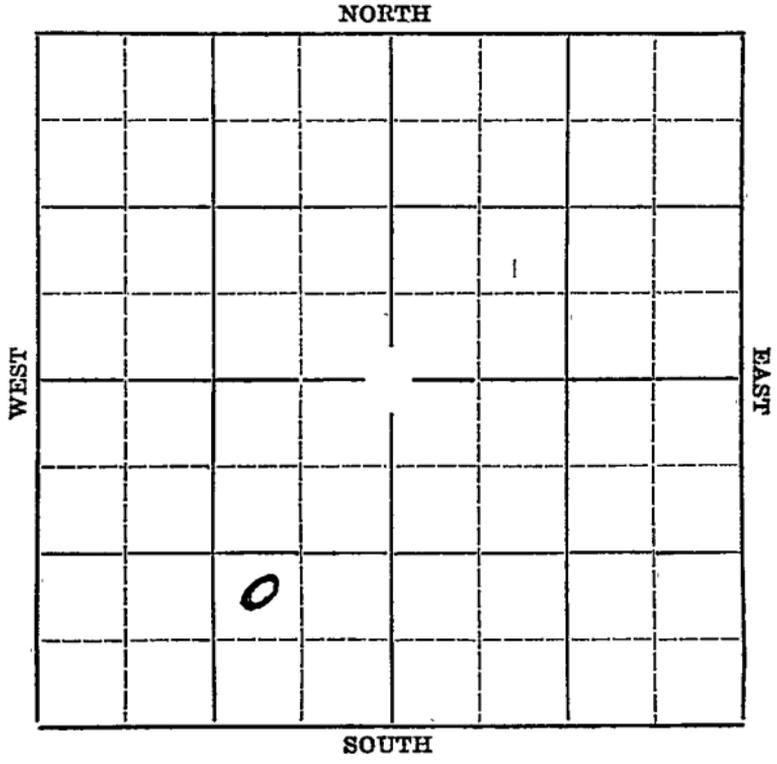

Sec. 25 Twp. 19 R. 11W

Well No. #5 Isern Farm

Sinclair-Prairie Company


_____ Ft. from N. Line

990' Ft. from S. Line

990 Ft. from E. Line

~~990'~~ Ft. from W. Line

Elev. 1767

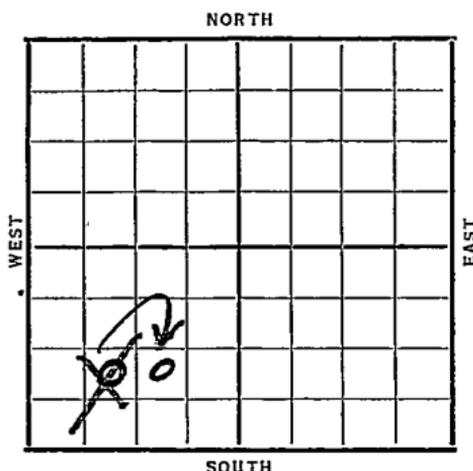

1936

REPORT

10/28

Location

11/6

Rigging up

11/12

15" @ 80' Drlg. 112

11/19

Drlg. 2987'.

11/27

Conglomerate 3279'.

Sil. 3359'. T. D. 3366'.

No oil showing.

12/3

Shut down.

12/9

Sil. 3359

Water D&A T.D. 3366

ABANDONED

Map No. 46 Sec. 25 Twp. 19 R. 11W

Well No. 5 Incon

Sinclair-Prairie Company

Contractor

SECTION PLAT

_____ Ft. from N. Line

990 Ft. from S. Line

990 Ft. from E. Line

_____ Ft. from W. Line

CORRECTION

Location _____

Rig up _____

Drilling and Remarks:

*Reported
N.E.S.W.*

RECORD

Cased _____ in., _____ ft.

Sand _____

Gas _____

Oil _____

Total Depth _____

PRODUCTION

1st 24 hrs. Nat. _____

1st 24 hrs. after shot _____

Gas _____ Cu. Ft.

Dry Hole _____

Abandoned _____

Date

NOV 4 1938 19

Scout

2-29-29

Map No. 46 Sec. 25 Twp. 19 R. 11W

Well No. 5 Isern

Sinclair Prairie Company

Contractor

SECTION PLAT

_____ Ft. from N. Line

990 Ft. from S. Line

_____ Ft. from E. Line

990 Ft. from W. Line

FIRST REPORT

Location ✓

Rig up _____

Drilling and Remarks:

RECORD

Cased _____ in., _____ ft.

Sand _____

Gas _____

Oil _____

Total Depth _____

PRODUCTION

1st 24 hrs. Nat. _____

1st 24 hrs. after shot _____

Gas _____ Cu. Ft.

Dry Hole _____

Abandoned _____

Date

OCT 28 1936 19

S. J. LEWIS Scout

KANSAS

Map No. 46 Sec. 25 Twp. 19 R. 11W

Well No. 5 Dscm

Sinclair-Prairie Company

Contractor

SECTION PLAT

	o		

_____ Ft. from N. Line

990 Ft. from S. Line

990 Ft. from E. Line

_____ Ft. from W. Line

ABANDONED

Location _____

Rig up _____

Drilling and Remarks:

Sc 8359

Water

JFH

RECORD

Cased _____ in., _____ ft.

Sand _____

Gas _____

Oil _____

Total Depth 3366

PRODUCTION

1st 24 hrs. Nat. _____

1st 24 hrs. after shot _____

Gas _____ Cu. Ft.

Dry Hole _____

Abandoned _____

Date

DEC 9 1936 19

S. J. LEWIS

Scout