

Company C. E. Ash et al


KANSAS

Barton

Sec. 25 Twp. 19 R. 11-W

Well No. #2 Roth Farm

C. E. Ash et al

Company

(Silica Pool)


Ft. from N. Line

990 Ft. from S. Line

660 Ft. from E. Line

Ft. from W. Line

Elev. 1771

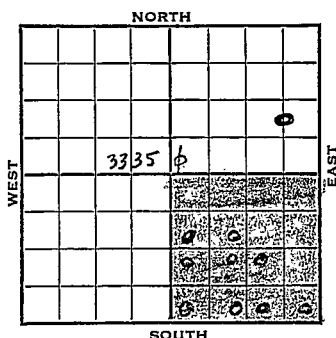

1942	REPORT
7/22	Drlg. 106' Soud 7/20/42
7/29	10" - 185' Drlg. 1728'
8/5	Drlg. 2780'
8/12	Arb. 3306-08 T.D. 7" 3306 Rust
Running 23' higher on Arbuckle than Derby dry hole in SW NE of Sec. 25. Running 6' higher on Arbuckle than Ash #1 Roth to north a. 343 bbl. producer. Running 7' lower than our #9 Matzek SE NW SE Sec. 25 completed for 1807 bbls. (Peabody)	
8/18	T.D. ³³²⁸ ~~3331~~ Filled up 2600' oil 8 hours To acidize and test (Tel) 1st oil 3311 Pay 3324- ~~3331~~ ³³²⁸ Swabbed 30 barrels 1st hour
8/19	Pay 3321-28 TD (Corr.-SLM) 2600' oil 8 hrs.
8/20	T.D. 3328 3000 acid Depthograph potential 1194 bbls (Telegram)

OVER

1942

8/27

Arb. 3306

7" - 3306

3000 acid

Depth Pot. 1194

T.D. 3328

Gravity 45.2

COMPLETED

Map No. 76 Sec. 25 Twp. 19 R. 11WWell No. 2 RothC. E. Ash et al. Company**FIRST REPORT**

Contractor

C NL SE NE**SECTION PLAT**

			o

_____ Ft. from N. Line

990 Ft. from S. Line660 Ft. from E. Line

_____ Ft. from W. Line

SILICA POOL

Location _____

Rig up _____

Drilling and Remarks:

Dr1g. 106'**Spud 7/20/42****RECORD**

Cased _____ in., _____ ft.

Sand _____

Gas _____

Oil _____

Total Depth _____

PRODUCTION

1st 24 hrs. Nat. _____

1st 24 hrs. after shot _____

Gas _____ Cu. Ft.

Dry Hole _____

Abandoned _____

Date

JUL 22 1942 19**S. J. LEWIS** Scout

Misc Small Maps	NY
Cards	Am
Tracing	NY
France Map	NY
Scarborough Map	NY
Moody Map	NY
Geological Dept.	
Lat Book	

Map No. 46 Sec. 25 Twp. 19 R. 11WWell No. 2 RothC. E. Ash et al.

Company

COMPLETED

Contractor

C NL SE NE

SECTION PLAT

			0

Ft. from N. Line

990

Ft. from S. Line

660

Ft. from E. Line

Ft. from W. Line

SILICA POOL

Location

Rig up

Drilling and Remarks:

CR 33062" CR 33063000 acidSept 10 1944452 Gr

RECORD

Cased in, ft.

Sand

Gas

Oil

Total Depth 3328

PRODUCTION

1st 24 hrs. Nat.

1st 24 hrs. after shot

Gas Cu. Ft.

Dry Hole

Abandoned

Date

AUG 27 1942

19

S. J. LEWIS

Scout

LIBRARY



CONTENTS

Misc. Small Maps	1
Cards	2
Tracing	3
France Map	4
Scarborough Map	5
Moody Map	6
Geological Dept.	7
Moody Flat Book	8