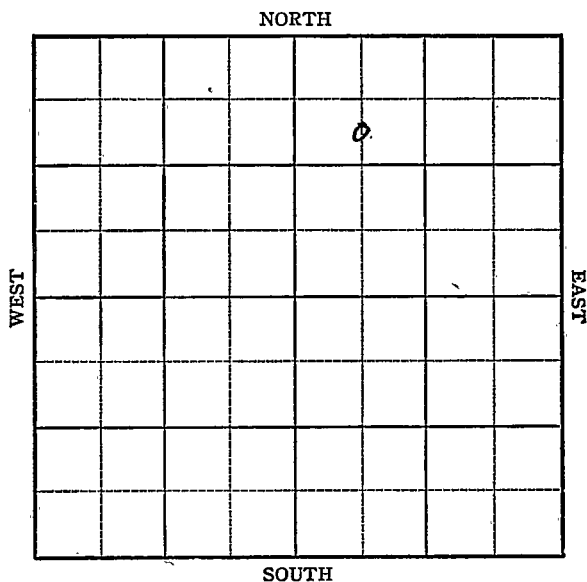


KANSASSection 25 Township 19 Range 11WWell No. 6 Roth "A"Company Francis Oil & Gas et alSilica Pool

Sec. 25 Twp. 19 R. 11W

Well No. #6 Roth "A" Farm

Francie Oil & Gas et al Company
Silica Pool (Veeder, Cont.)


990' Ft. from N. Line

Ft. from S. Line

Ft. from E. Line

660' Ft. from W. Line

C S L NW NE

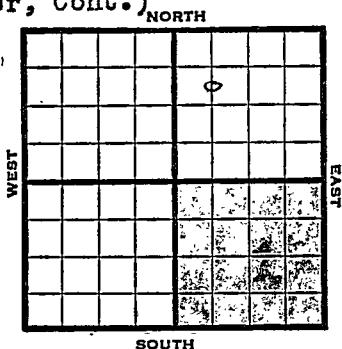

1949 Elev 1769' REPORT

5/25 Location
6/1 8" @ 228'
Drlg 534'
6/7 Lansing 3010' Arbuckle 3284'
TD 3287'
5" @ 3285'
6/15 "
6/21 "
6/29 TD 3299
Arb. 3284'
Aband.

ABANDONED

Map No. _____ Sec. 25 Twp. 19 R. 11W

Well No. 6 Roth "A"

Francis Oil & Gas etal. Company

Veeder Contractor

C S L NW NE

**FIRST REPORT
SECTION PLAT**

990 Ft. from N. Line

_____ Ft. from S. Line

_____ Ft. from E. Line

660 Ft. from W. Line

Barton County

Location X

Rig up _____

Drilling and Remarks: _____

RECORD

Cased _____ in., _____ ft.

Sand _____

Gas _____

Oil _____

Total Depth _____

PRODUCTION

1st 24 hrs. Nat. _____

1st 24 hrs. after shot _____

Gas _____ Cu. Ft.

Dry Hole _____

Abandoned _____

Date

MAY 25 1949 19 S. J. LEWIS Scout

Map No. K46 Sec. 25 Twp. 19 R. 11W

Well No. 6 Roth "A"

Francis Oil & Gas etal. Company

ABANDONED

Contractor

C S L NW NE


E 11768
SECTION PLAT

990 Ft. from N. Line

_____ Ft. from S. Line

_____ Ft. from E. Line

660 Ft. from W. Line

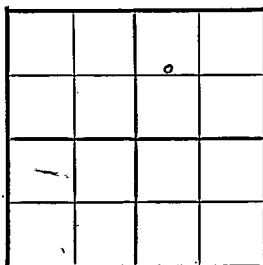

Barton County

Location _____

Rig up _____

Drilling and Remarks:

Box 3287

RECORD

Cased _____ in., _____ ft.

Sand _____

Gas _____

Oil _____

Total Depth 3299

PRODUCTION

1st 24 hrs. Nat. _____

1st 24 hrs. after shot _____

Gas _____ Cu. Ft.

Dry Hole _____

Abandoned _____

Date

JUN 29 1949 19

S. J. LEWIS Scout