


Section 25 Township 19 Range 11W

Well No. 2 Isern

Company Eldorado Ref. et al



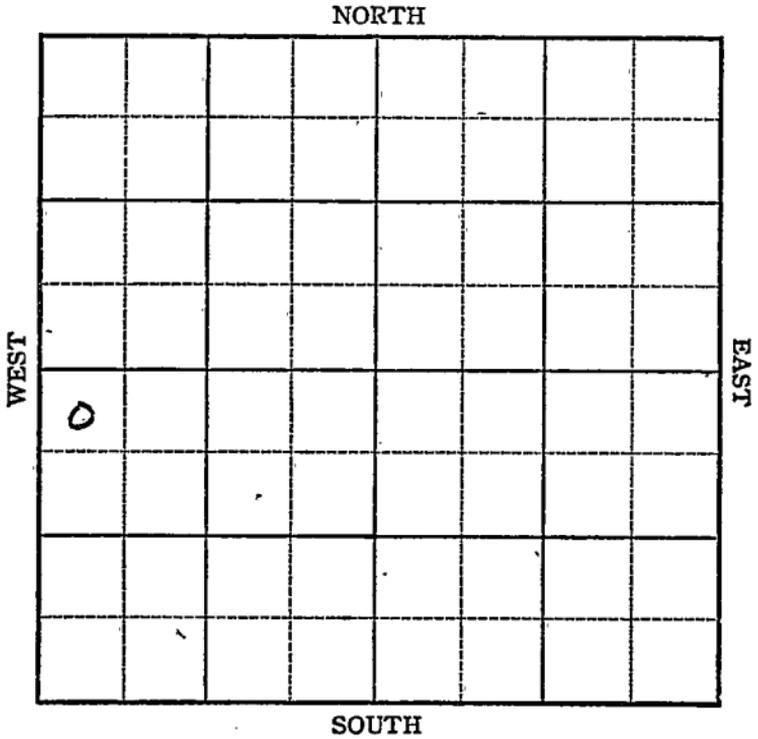

Sec. 25 Twp. 19 R. 11-W

Well No. #2 Isern Farm

Eldorado Ref. etal Company


Silica Pool

330 Ft. from N. Line

\_\_\_\_\_ Ft. from S. Line

\_\_\_\_\_ Ft. from E. Line

330 Ft. from W. Line

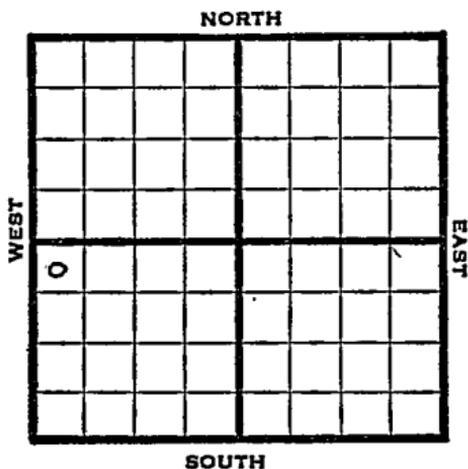

NW SW

1947

REPORT

Elev. 1767'

6/18

8" @ 202  
Drlg. 1774'

6/24

Arbuckle 3281-82 TD  
5" @ 3281'  
RUST

7/1

TD 3287'  
2700' oil in 30 hrs.

7/8

" "

7/16

TD 3287'

7/22

" "

7/30

Arb. 3281'  
5" @ 3281'  
Pump 350 Pot  
Gr. 42.8  
TD 3287'

**COMPLETED**

Map No. \_\_\_\_\_ Sec. 25 Twp. 19 R. 11W

Well No. 2 Isern

Eldorado Ref etal. Company

**FIRST REPORT**

Contractor

NW SW

**SECTION PLAT**

330 Ft. from N. Line

\_\_\_\_\_ Ft. from S. Line

\_\_\_\_\_ Ft. from E. Line

330 Ft. from W. Line

o			

Barton County

Location \_\_\_\_\_

Rig up \_\_\_\_\_

Drilling and Remarks:

8" @ 202

drlg. 1774

**RECORD**

Cased \_\_\_\_\_ in, \_\_\_\_\_ ft.

Sand \_\_\_\_\_

Gas \_\_\_\_\_

Oil \_\_\_\_\_

Total Depth \_\_\_\_\_

**PRODUCTION**

1st 24 hrs. Nat. \_\_\_\_\_

1st 24 hrs. after shot \_\_\_\_\_

Gas \_\_\_\_\_ Cu. Ft.

Dry Hole \_\_\_\_\_

Abandoned \_\_\_\_\_

Date

JUN 1 8 1947 19

S. J. LEWIS Scout

Kansas

Map No. 46 Sec. 25 Twp. 19 R. 11W

Well No. 2 Isern

Eldorado Ref. etal. Company

COMPLETE Contractor

NW SW

E 11762  
SECTION PLAT

330 Ft. from N. Line

\_\_\_\_\_ Ft. from S. Line

\_\_\_\_\_ Ft. from E. Line

330 Ft. from W. Line

o			

Barton County

RECORD

Location \_\_\_\_\_

Rig up \_\_\_\_\_

Drilling and Remarks:

Cased \_\_\_\_\_ in., \_\_\_\_\_ ft.

Sand \_\_\_\_\_

Gas \_\_\_\_\_

Oil \_\_\_\_\_

Total Depth 8287

*Cor 83281*  
*5109281*  
*Pump 350 ft*  
  
*42 ft*

PRODUCTION

1st 24 hrs. Nat. \_\_\_\_\_

1st 24 hrs. after shot \_\_\_\_\_

Gas \_\_\_\_\_ Cu. Ft.

Dry Hole \_\_\_\_\_

Abandoned \_\_\_\_\_

Date

JUL 30 1947

19

S. J. LEWIS

Scout