
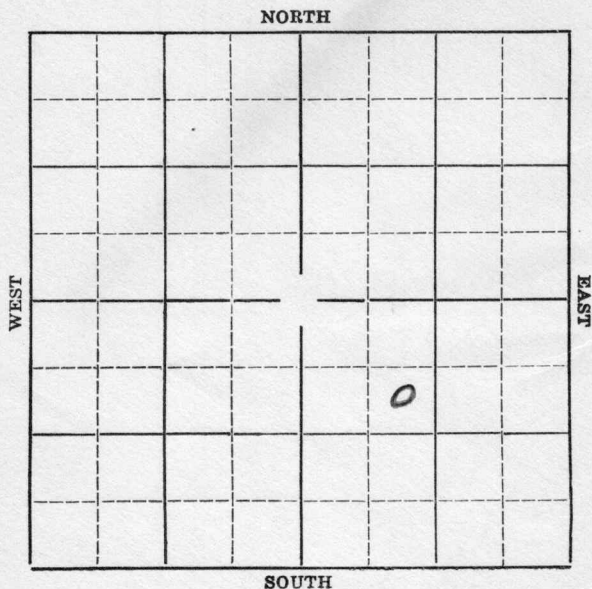


Section 25 Township 19 Range 11-WWell Number #9-MatzekCompany Mid-Continent Petroleum Corp.

Sec. 25 Twp. 19 R. 11WWell No. #9 Matzek FarmMid-Continent Pet. Company990' Ft. from N. Line Ft. from S. Line Ft. from E. Line990' Ft. from W. Line

Elev. 1764

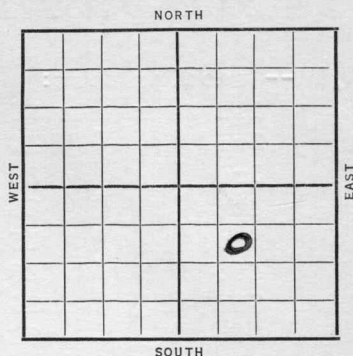

Date

REPORT

8/26 Building rig.

9/3 Rig.

9/11 T.D. 200 Crooked hole

Skid rig 16 feet Start new hole (Tel)

9/17 Dlg. 1715 (Tel) (new hole)

9/18 Dlg. 1925 (Tel)

9/19 Dlg. 2235 (Tel)

9/21 Dlg. 2735 (Tel)

9/24 Will core tomorrow (Tel)

9/25 T.D. 3100 Will core for top of

Siliceous tomorrow Expect around

3275 (Tel)

9/27 Top Siliceous 3292 T.D. 3299

Nice saturation (Telegram)

10/1 7" @ 3292'.

10/5 Drilling cement (Tel)

10/7 Drilled plugs Filled up 1800 feet oil
in 2 hours May deepen (Tel)10/12 Had bad hole Plugged back Drilling
out cement 2 feet off bottom (Tel)

(OVER)

10/13--Top Siliceous 3292 T.D. 3300
Filled up 2600 feet oil in 5 hrs. (Tel)

10/14--Swabbing test:

1st hour	made	20	bbls.
2nd	"	40	"
3rd	"	20	"
4th	"	20	"
5th	"	15	"
6th	"	20	"
7th	"	20	"
8th	"	20	"
9th	"	20	"
10th	"	20	"
11th	"	15	"
12th	"	20	"
13th	"	15	"
14th	"	20	"

Swabbing to bottom hole
Will run tubing and acidize (Tel)

10/15--Deepened 1 foot T.D. 3301
No increase Will acidize (Tel)

10/16--Acidized with 1,000 gallons acid (Tel)

10/19--Potential 1,807 bbls. (Tel)

10/21/36--Sil. 3292'.
T.D. 3301'.
1000 gallons of acid.
1807 bbls of oil potential.

COMPLETED

12/18/36--60 day retest 1776 bbls. (Telegram)

4/17--120 day retest ~~XX~~ 844 bbls. (Telegram)

10/4/37--New potential 356 bbls. (Tel)


Contractor

SECTION PLAT

		0	

990 Ft. from N. Line

_____ Ft. from S. Line

_____ Ft. from E. Line

990 Ft. from W. Line

COMPLETED

Location _____

Rig up _____

Drilling and Remarks:

S. 13292.1000 acidPotential1807.

RECORD

Cased _____ in., _____ ft.

Sand _____

Gas _____

Oil _____

Total Depth 3301

PRODUCTION

1st 24 hrs. Nat. _____

1st 24 hrs. after shot _____

Gas _____ Cu. Ft.

Dry Hole _____

Abandoned _____

Date

OCT 21 1936

19

S. J. LEWIS

Scout

KANSAS

Page 12 of 12

Map No.

Well

Company

Inspector

SECTION PLAT



Fr. from N. line

Fr. from S. line

Fr. from E. line

Fr. from W. line

RECORD

Location

in

Cased

Shed

Rise up

Drilling and Remarks

Returned	
Cards	<i>[Signature]</i>
Tracing	<i>[Signature]</i>
France Map	<i>[Signature]</i>
Scarborough Map	<i>[Signature]</i>
Moody Map	<i>[Signature]</i>
Scarborough Plat Book	<i>[Signature]</i>
Moody Plat Book	<i>[Signature]</i>

Date

KANSAS

Map No. 76 Sec. 25 Twp. 19 R. 11WWell No. 9 MatzekMid-Continental Petroleum Company

Contractor

SECTION PLAT

990 Ft. from N. Line

_____ Ft. from S. Line

_____ Ft. from E. Line

990 Ft. from W. Line

FIRST REPORT

Location _____

Rig up _____

Drilling and Remarks:

Building rig

RECORD

Cased _____ in., _____ ft.

Sand _____

Gas _____

Oil _____

Total Depth _____

PRODUCTION

1st 24 hrs. Nat. _____

1st 24 hrs. after shot _____

Gas _____ Cu. Ft.

Dry Hole _____

Abandoned _____

Date

AUG 26 1936 19S. J. LEWIS

Scout

FIRST REPORT
RECORD

[Large handwritten signature across the top half of the page]

[Handwritten initials "JH" in the upper right corner]

Returned	<i>[Signature]</i>
Cards	<i>[Signature]</i>
Tracing	<i>[Signature]</i>
France Map	<i>[Signature]</i>
Scarborough Map	<i>[Signature]</i>
Moody Map	<i>[Signature]</i>
Scarborough Plat Book	
Moody Plat Book	

2. J. LEWIS