

FORM M41

DRILLING WELL COMPLETION REPORT

Well No. Ten (10) Farm Name Anton Matzek
Date completed October 21, 1942
Description SE $\frac{1}{4}$ Sec. 25-19S-11W
County Barton, State Kansas
Initial production 95 bbls. Total depth 3311 feet
Initial volume _____ cu. ft. _____ lbs. rock pressure
Pipe Line Company Skelly
Gas Company _____
Remarks: Daily allowed 15 bbls.

Accounting Dept.
Rental Dept.
Scouting Dept. ✓
Engineering Dept.
Legal Dept.
Lease Inventory Man
Tax Dept.
Geological
File


Commodity
bw

LOCATION NOTICE

TULSA, OKLA., August 28, 1942

WELL NO. 10 ON Anton Matzek FARM

WILL BE AS FOLLOWS:

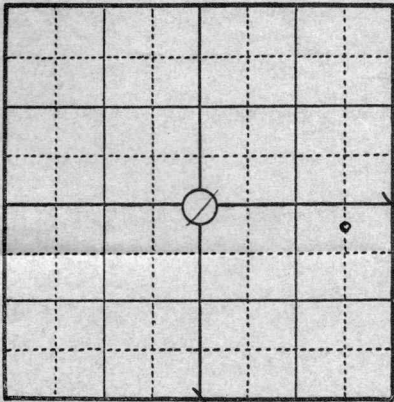

330 FEET FROM NORTH LINE
660 FEET FROM EAST LINE
 FEET FROM SOUTH LINE
 FEET FROM WEST LINE

IN SE 1 SEC. 25 TWP. 19S RANGE 11W
Barton COUNTY, STATE OF Kansas

REMARKS: S. K. McLamhan, Dist. Foreman

SIGNED [Signature]

COPIES TO

DISTRICT SUPT.
 ACCOUNTING DEPT.
 RENTAL DEPT.
 SCOUTING DEPT. ✓
 ENGINEERING DEPT.
 LEGAL DEPT.
 LEASE INVENTORY
 CLAIM DEPT.
 TAX DEPT.
 GEOLOGICAL DEPT.
 FILE
 PURCHASING DEPT.

605
Carls
county
road
RAM