


DRILLING WELL COMPLETION REPORT

Well No. Nine (9) 2nd Hole Farm Name Anton Matzek
Date ~~drilling~~ completed 10-20-36
Description SE¹ Section 25-19S-11W
County Barton, State Kansas
Initial production 1,805 bbls. Total depth 3,301 feet
Initial volume _____ cu. ft. _____ lbs. rock pressure
Pipe Line Company _____
Gas Company _____
Remarks: MCPC Interest - All
Daily allowable 91.25 barrels

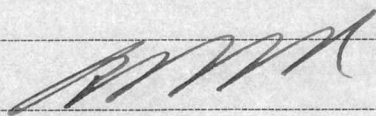

Accounting Dept.
Rental Dept.
Scouting Dept.
Engineering Dept.
Legal Dept.
Lease Inventory Man
Tax Dept.
Geological
File

DRILLING WELL COMPLETION REPORT

Well No. NINE (9) Farm Name ANTON MATZEK
Date ~~drilling~~ completed September 14, 1936
Description SE $\frac{1}{4}$ Sec. 25-19S-11W
County Barton, State Kansas
Initial production LOST HOLE bbls. Total depth 200 feet
Initial volume _____ cu. ft. _____ lbs. rock pressure
Pipe Line Company _____
Gas Company _____
Remarks: M.C.P.C. interest -All
Crooked hole. Skidded rig 16' West to start new hole.

Commodity


Accounting Dept.
Rental Dept.
Scouting Dept. ✓
Engineering Dept.
Legal Dept.
Lease Inventory Man
Tax Dept.
Geological
File

LOCATION NOTICE

TULSA, OKLA., September 14, 1936 193.

WELL NO. NINE (9) (2nd.Hole) ON ANTON MATZEK FARM

WILL BE AS FOLLOWS:

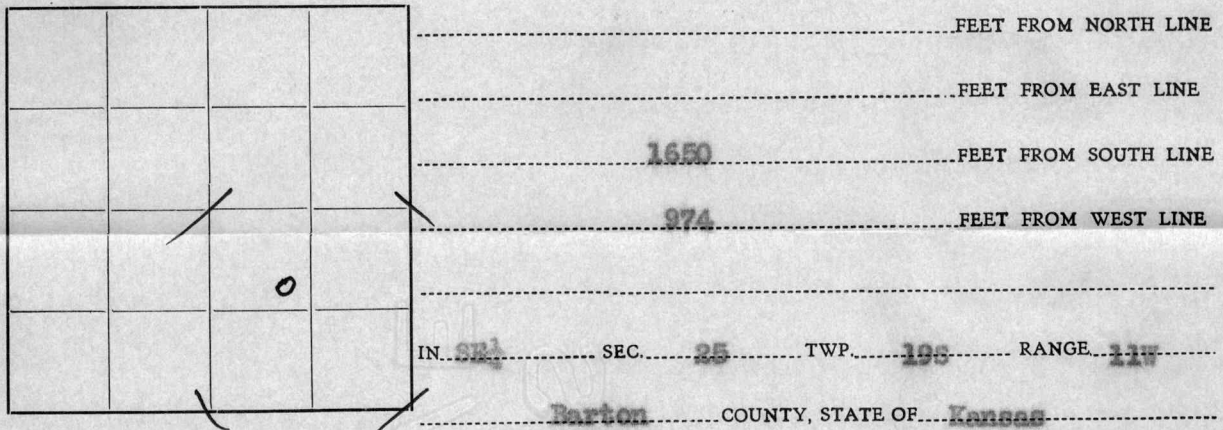

REMARKS:

COPIES TO SIGNED Goody


- DISTRICT SUPT.
- ACCOUNTING DEPT.
- RENTAL DEPT.
- SCOUTING DEPT. ✓
- ENGINEERING DEPT.
- LEGAL DEPT.
- CLAIM DEPT.
- TAX DEPT.
- GEOLOGICAL DEPT.
- FILE
- LEASE INVENTORY

LOCATION NOTICE

TULSA, OKLA., August 21, 1936 .193

WELL NO. NINE (9) ON ANTON MATZEK FARM

WILL BE AS FOLLOWS:

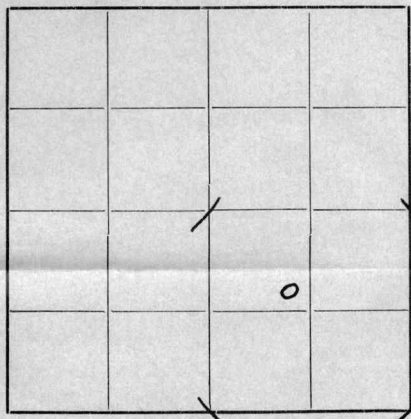

FEET FROM NORTH LINE
 FEET FROM EAST LINE
 1650 FEET FROM SOUTH LINE
 990 FEET FROM WEST LINE
 IN SE 1/4 SEC. 25 TWP. 19S RANGE 11W
Barton COUNTY, STATE OF Kansas

REMARKS:

COPIES TO

SIGNED

DISTRICT SUPT.
 ACCOUNTING DEPT.
 RENTAL DEPT.
 SCOUTING DEPT. ✓
 ENGINEERING DEPT.
 LEGAL DEPT.
 CLAIM DEPT.
 TAX DEPT.
 GEOLOGICAL DEPT.
 FILE
 LEASE INVENTORY

W. A. ...
...
...