


# KANSAS

Barton

Section 25 Township 19S Range 12W

Well No. #1 Petz

Company W. L. Hartman

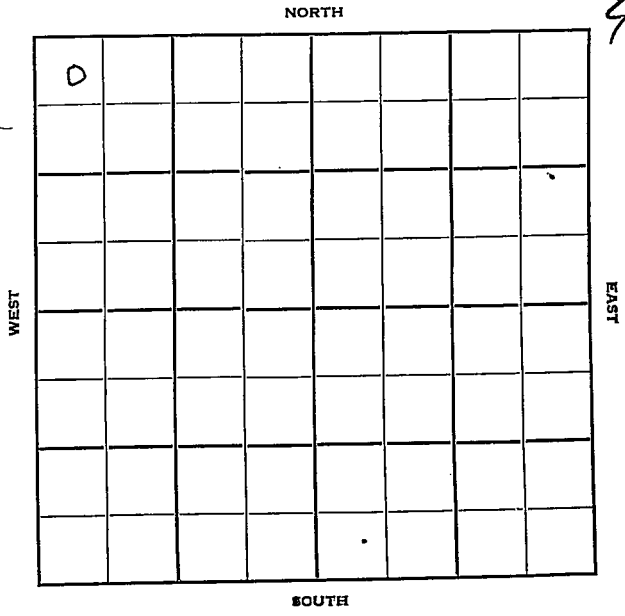

Sec. 25 Twp. 19 R. 12-W

Well No. #1 Petz Farm

W L Hartman Company

Cont- Hartman  
Hammer


330 Ft. from N. Line

\_\_\_\_\_ Ft. from S. Line

\_\_\_\_\_ Ft. from E. Line

330 Ft. from W. Line

NW/C

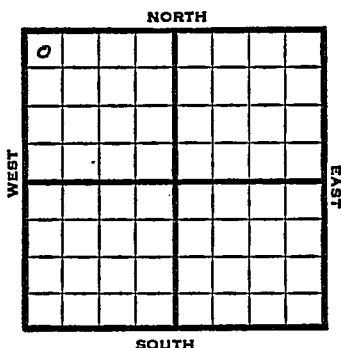

1949

Elev. 1802' REPORT

10/12 Surface Hole  
10/19 8" @ 172'  
Drlg 3078'

10/26 Lans 3101'  
Arb 3411'  
TD 3443'

**ABANDONED**

Map No. \_\_\_\_\_ Sec. 25 Twp. 19 R. 12W

Well No. 1 Petz

W. L. Hartman Company

Hartman Contractor

NW/C

FIRST REPORT  
SECTION PLAT

330 Ft. from N. Line

\_\_\_\_\_ Ft. from S. Line

\_\_\_\_\_ Ft. from E. Line

330 Ft. from W. Line

°			

Barton County

Location \_\_\_\_\_

Rig up \_\_\_\_\_

Drilling and Remarks:

surface hole

RECORD

Cased \_\_\_\_\_ in., \_\_\_\_\_ ft.

Sand \_\_\_\_\_

Gas \_\_\_\_\_

Oil \_\_\_\_\_

Total Depth \_\_\_\_\_

PRODUCTION

1st 24 hrs. Nat. \_\_\_\_\_

1st 24 hrs. after shot \_\_\_\_\_

Gas \_\_\_\_\_ Cu. Ft.

Dry Hole \_\_\_\_\_

Abandoned \_\_\_\_\_

Date

OCT 12 1949 19

S. J. LEWIS Scout

Kansas

Map No. \_\_\_\_\_ Sec. 25 Twp. 19 R. 12W

Well No. I Petz

W. L. Hartman Company

ABANDONED

Contractor

NW/C

E. 1803  
SECTION PLAT

330 Ft. from N. Line

\_\_\_\_\_ Ft. from S. Line

\_\_\_\_\_ Ft. from E. Line

330 Ft. from W. Line

0			

Barton County

Location \_\_\_\_\_

Rig up \_\_\_\_\_

Drilling and Remarks:

Lease 3101

Cery 3411

## RECORD

Cased \_\_\_\_\_ in., \_\_\_\_\_ ft.

Sand \_\_\_\_\_

Gas \_\_\_\_\_

Oil \_\_\_\_\_

Total Depth 3443

## PRODUCTION

1st 24 hrs. Nat. \_\_\_\_\_

1st 24 hrs. after shot \_\_\_\_\_

Gas \_\_\_\_\_ Cu. Ft.

Dry Hole \_\_\_\_\_

Abandoned \_\_\_\_\_

Date

OCT 26 1949

19

S. I. LEWIS

Scout