KANSAS


FORM 51 5M 1-42 PETROL

Barton

Section 25 Township 19 Range 12-W

Well No. 1 Berscheidt

Company E. B. Shawver

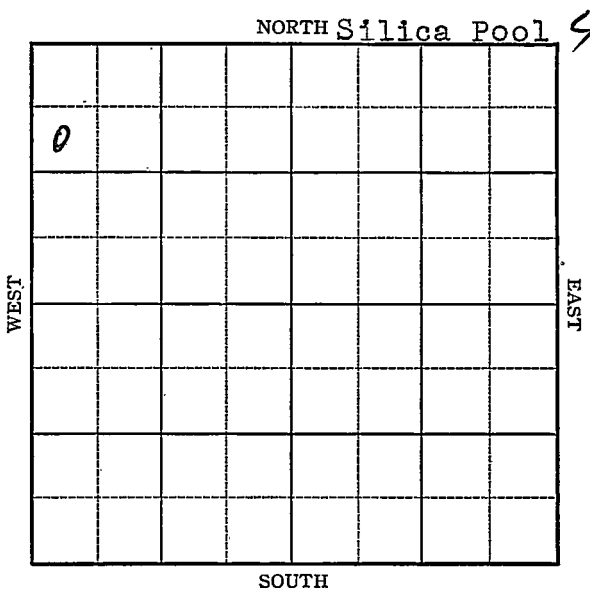

FORM 252-A
5M 10-41 PETROL

KANSAS

Barton

Sec. 25 Twp. 19 R. 12-W

Well No. #1 Berscheidt Farm

E. B. Shawver Company


(Silica)

990 Ft. from N. Line

Ft. from S. Line

Ft. from E. Line

330 Ft. from W. Line

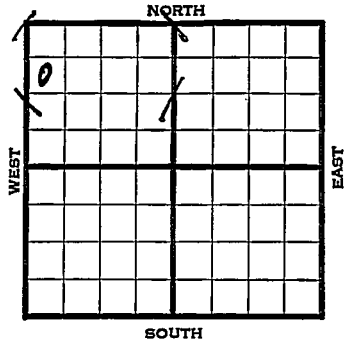

Elev. 1802

1942	REPORT
3/4	Surface hole.
3/12	8" - 175' Anhy. 587' Topeka 2649'
	Drlg. 2675'
3/19	Lans. 3101' S.O. 3108-12', 3125-27,
	3181-96' Cong. 3358' Arb. 3372'
	5" - 3372' T.D. 3378'
3/25	Arb. 3372'
	5" - 3372'
	T.D. 3402'
	Water.
	ABANDONED

Form 26 200 Bks. 5-41 McW. Barton KANSAS

Map No. 46 Sec. 25 Twp. 19 R. 12W

Well No. 1 Berscheidt

E. B. Shawver Company

FIRST REPORT Contractor

SW NW NW


990 Ft. from N. Line

_____ Ft. from S. Line

_____ Ft. from E. Line

330 Ft. from W. Line

SECTION PLAT

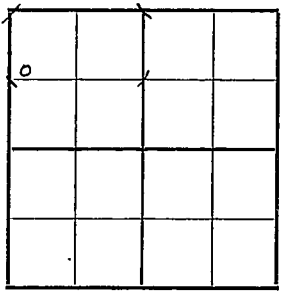

SILICA POOL

Location _____

Rig up _____

Drilling and Remarks:

Surface Hole

RECORD

Cased _____ in., _____ ft.

Sand _____

Gas _____

Oil _____

Total Depth _____

PRODUCTION

1st 24 hrs. Nat. _____

1st 24 hrs. after shot _____

Gas _____ Cu. Ft.

Dry Hole _____

Abandoned _____

Date

MAR 4 1942 19 S. J. LEWIS Scout

Form 26 200 Bks. 5-41 McW. Barton KANSAS

Map No. 46 Sec. 25 Twp. 19 R. 12W

Well No. 1 Berscheidt

E. B. Shawver Company

ABANDONED Contractor

SW NW NW


990 Ft. from N. Line

____ Ft. from S. Line

____ Ft. from E. Line

330 Ft. from W. Line

SECTION PLAT

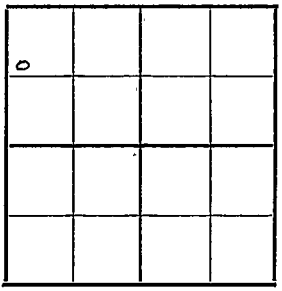

WILDCAT

Location ____

Rig up ____

Drilling and Remarks:

Cs & 3372.
5" @ 3372
Water

RECORD

Cased ____ in., ____ ft.

Sand ____

Gas ____

Oil ____

Total Depth 3402.

PRODUCTION

1st 24 hrs. Nat. ____

1st 24 hrs. after shot ____

Gas ____ Cu. Ft.

Dry Hole ____

Abandoned ____

Date

MAR 25 1942 19 S. J. LEWIS Scout