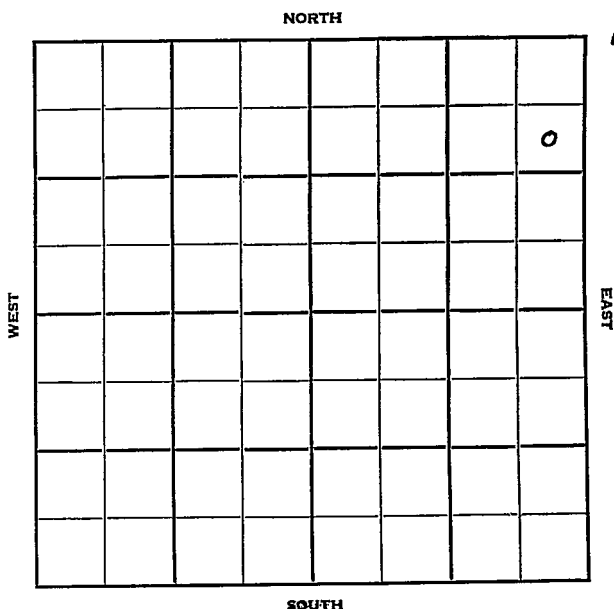


Section 25 Township 19 Range 12 WWell No. #1 BrodieCompany W. L. Hartman

Barton

KANSAS

Sec. 25 Twp. 19 R. 12W

Well No. #1 Brodie Farm

W. L. Hartman Company

H & H Drlg. - Contr. Contractor


990' Ft. from N. Line.

 Ft. from S. Line

330' Ft. from E. Line

 Ft. from W. Line

SE NE NE

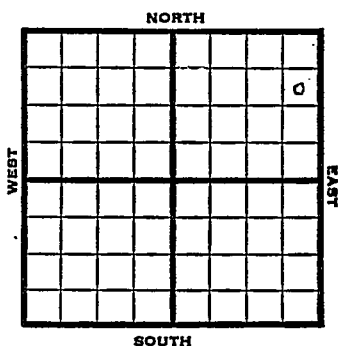


1951 Elev. 1799' REPORT

1/31 8" @ 180'

4/4 Spud 2-3-51 Oil well TD 3375'
8" @ 180 Top. 2683' Heeb 2945'
B. Oread 2975' Br. lime 3063'
Lans 3081'
DST 3102-14 open $\frac{1}{2}$ hr. Rec 75' G&OCM
DST 3120-50 open 1 hr. Rec. 8' mud
DST 3165-72 open 1 hr. Rec. 14' mud
DST 3176-88 open 1 hr. Rec. 32' HOCM
Cong. 3346' Arb. 3350-53 5" @ 3351
TD 3375 42/3310-19 FU 150' free
oil FU 1200' oil overnite
PB 3330 S/ 15 BOPH 46/3100-12
600 A S/ 10 BOPH
Comp. 334 BOPD

COMPLETED

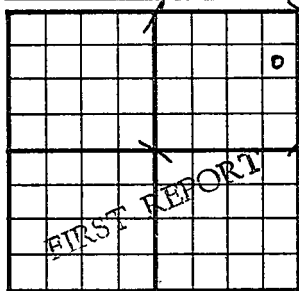County Barton State KansasSec. 25 (Blk.) 19 (Sur.) 12W Map No.Operator W. L. HartmanWell No. 1 Farm BrodieElev. _____ Location SE NE NE990 Ft. From N Line NE330 Ft. From E Line Quarter1st. Report JAN 31 1951

Completion _____

Remarks _____


H & H Drlg. - Contr.

Spudding Date _____

Drlg. Data _____

8" @ 180

J. E. TYRA

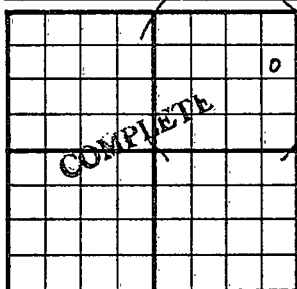County Barton State KansasSec. 25 (Blk. Twp.) 19 (Sur. Rge.) 12W Map No.Operator W. L. HartmanWell No. 1 Farm BrodieElev. 1799 Location SE NE NE990 Ft. From N Line NE330 Ft. From E Line Quarter1st. ReportCompletion APR 4 1951RemarksH & H Drlg. - Contr.Spudding Date 2-3-51Drlg. Data Oil well TD 33758" @ 180 Top. 2683 Heeb. 2945B. Oread 2975 Br. lime 3063 Lans. 3081DST 3102-14 open $\frac{1}{2}$ hr. Rec. 75' g & ocmDST 3120-50 open 1 hr. Rec. 8' mudDST 3165-72 open 1 hr. Rec. 14' mudDST 3176-88 open 1 hr. Rec. 32' hoomCong. 3346 Arb. 3350-53 5" @ 3351TD 3375 42/ 3310-19 FU 150' free oilFU 1200' oil overnite PB 3330S/ 15 boph 46/ 3100-12 600 AS/ 10 boph Comp. 334 boph

J. E. TYRA